



AS BUILT DRAWING OF BLOCK NO-1
BUILDING OF PRASANNAMANI COLLEGE OF PHYSICAL EDUCATION & YOGA, TIGIRIA, CUTTACK

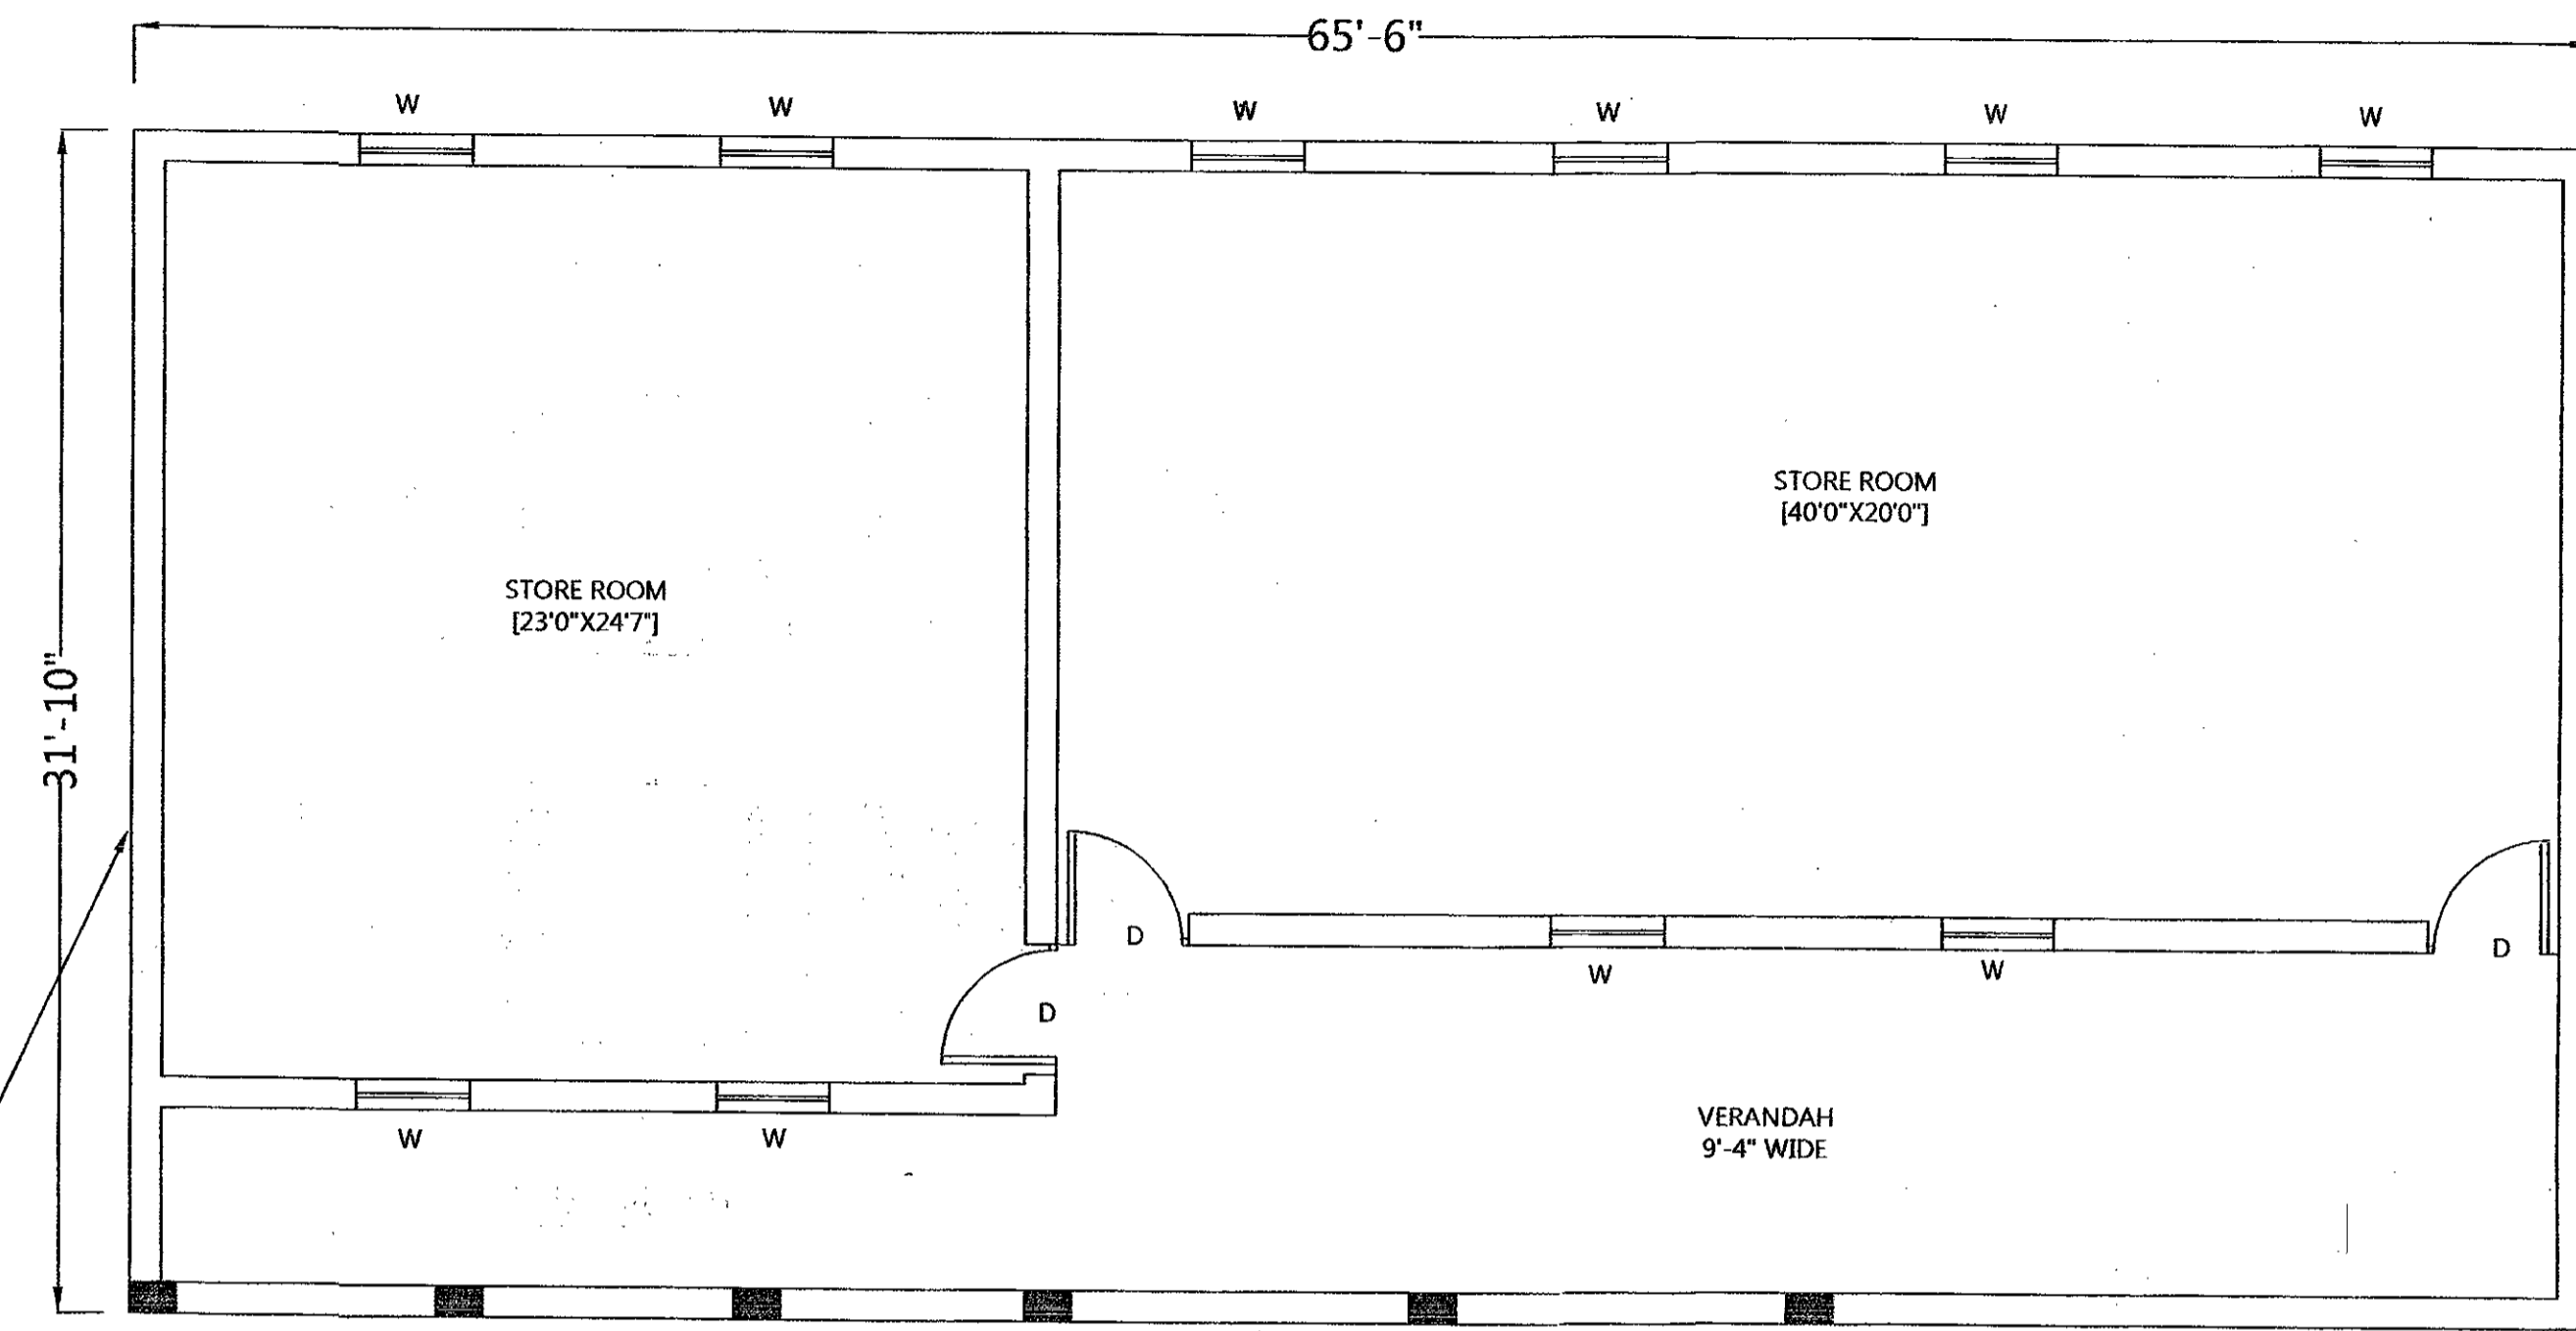

COMPLETED IN THE YEAR OF 1995
(USED FOR C.P.Ed COURSE)


(FIRST FLOOR PLAN)

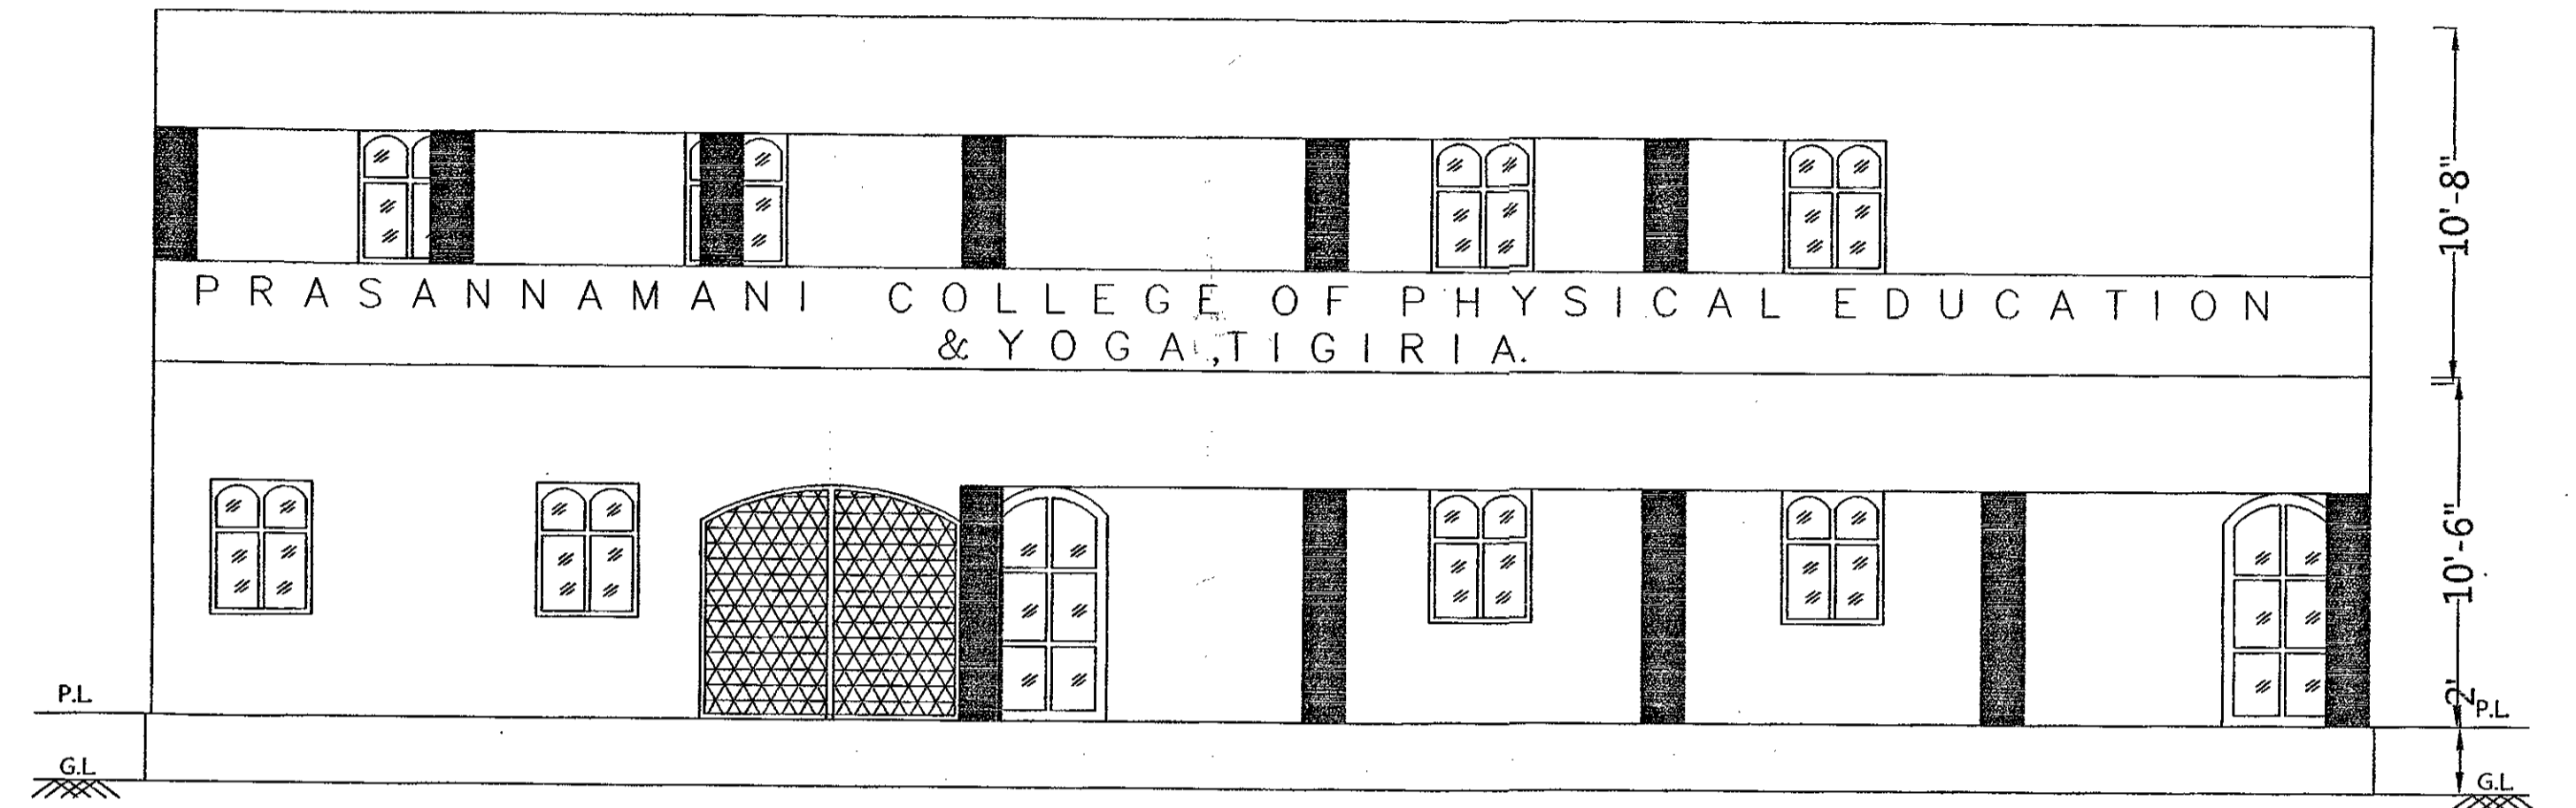

(FRONT ELEVATION)

RA-NO-361/362
Plot no-164-A2-86 Dec
ON-124500 Sqft
Total Area of plot-11,442 Sqft
Total Built up Area-2085 Sqft (1st Floor)
2085 Sqft (Front Floor)
total 4170 Sqft

Asst. Engineer
Tigiria B.O.

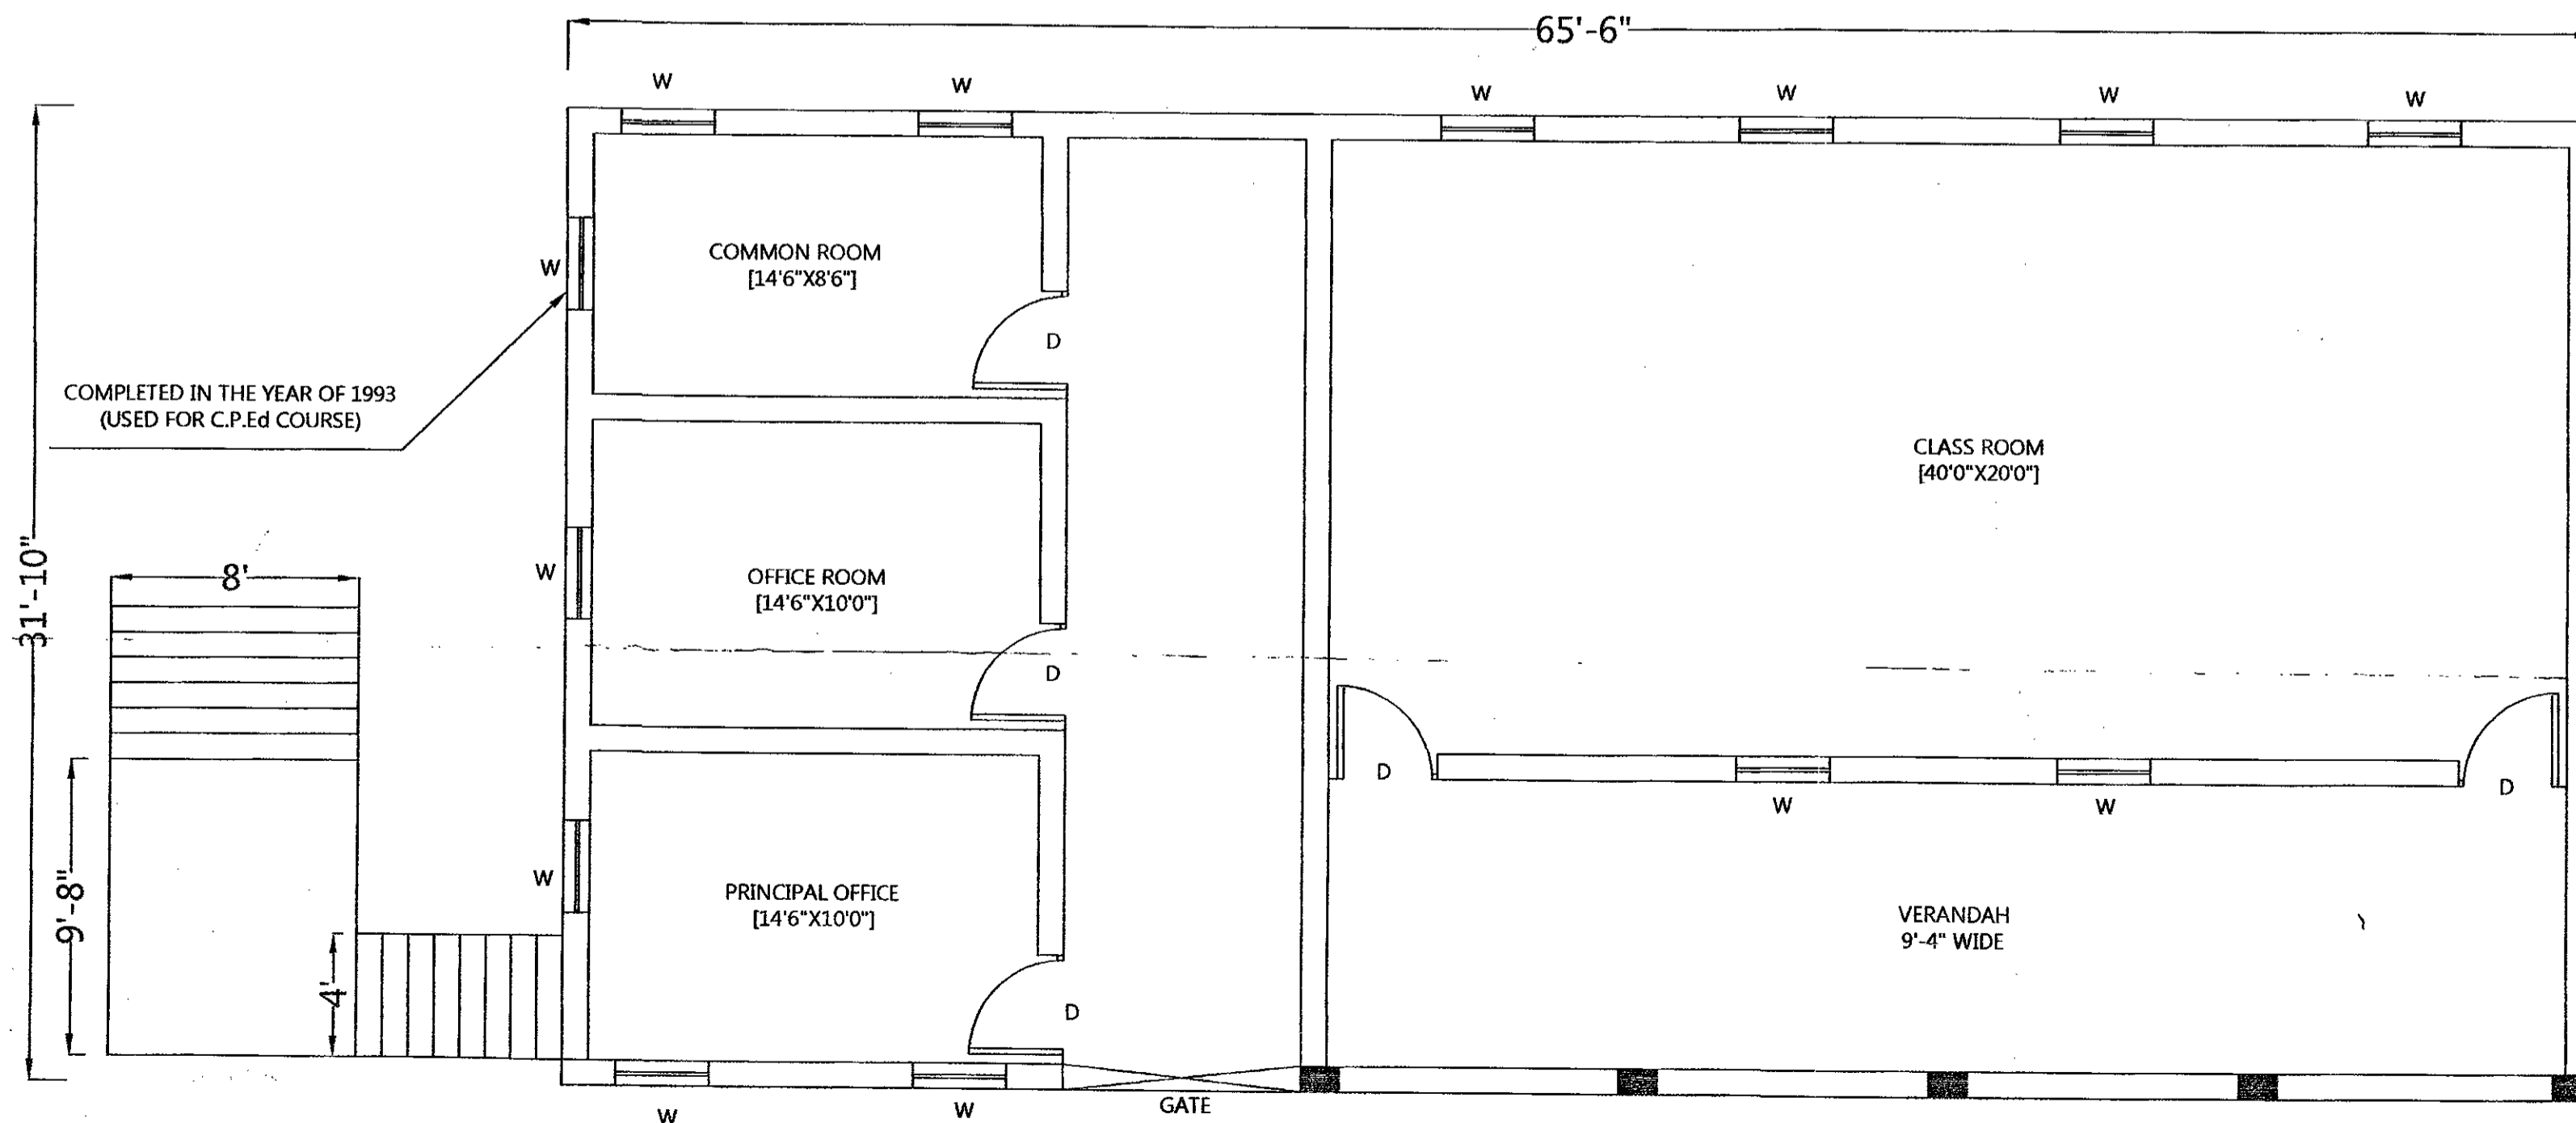

COMPLETED IN THE YEAR OF 1993
(USED FOR C.P.Ed COURSE)

(GROUND FLOOR PLAN)

DOOR & WINDOW SCHEDULE

D	3'-6"x7'-0"
W	3'-0"x4'-0"

NAME OF THE CONSULTANT:-

SUVADRA
CONSULTANTS


(Approved by Govt. of Odisha.) (An ISO 2000:2008 Certified.)
Soil Testing Laboratory & Engineering Consultant.
REGD. OFF.-PP-97, Tankapani Road Bhubaneswar-751018, Odisha.
Phone-(0674)6536124 Fax-0674-2432090
E-mail-suvadra_consults@yahoo.com
Web-www.suvadraconsultants.com

PROJECT TITLE:-
AS BUILT DRAWING OF BLOCK NO-1
BUILDING OF PRASANNAMANI COLLEGE OF PHYSICAL
EDUCATION & YOGA, TIGIRIA, CUTTACK


Drawn By:-
Er. A.Mohapatra

Checked By:-


PLINTH AREA=2085 Sq ft

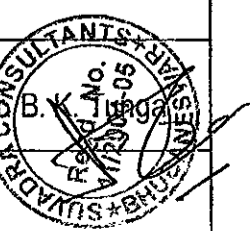

AS BUILT PLAN OF BLOCK NO-2 FOR PRASANMANI
COLLEGE OF PHYSICAL EDUCATION AND YOGA AT TIGIRIA

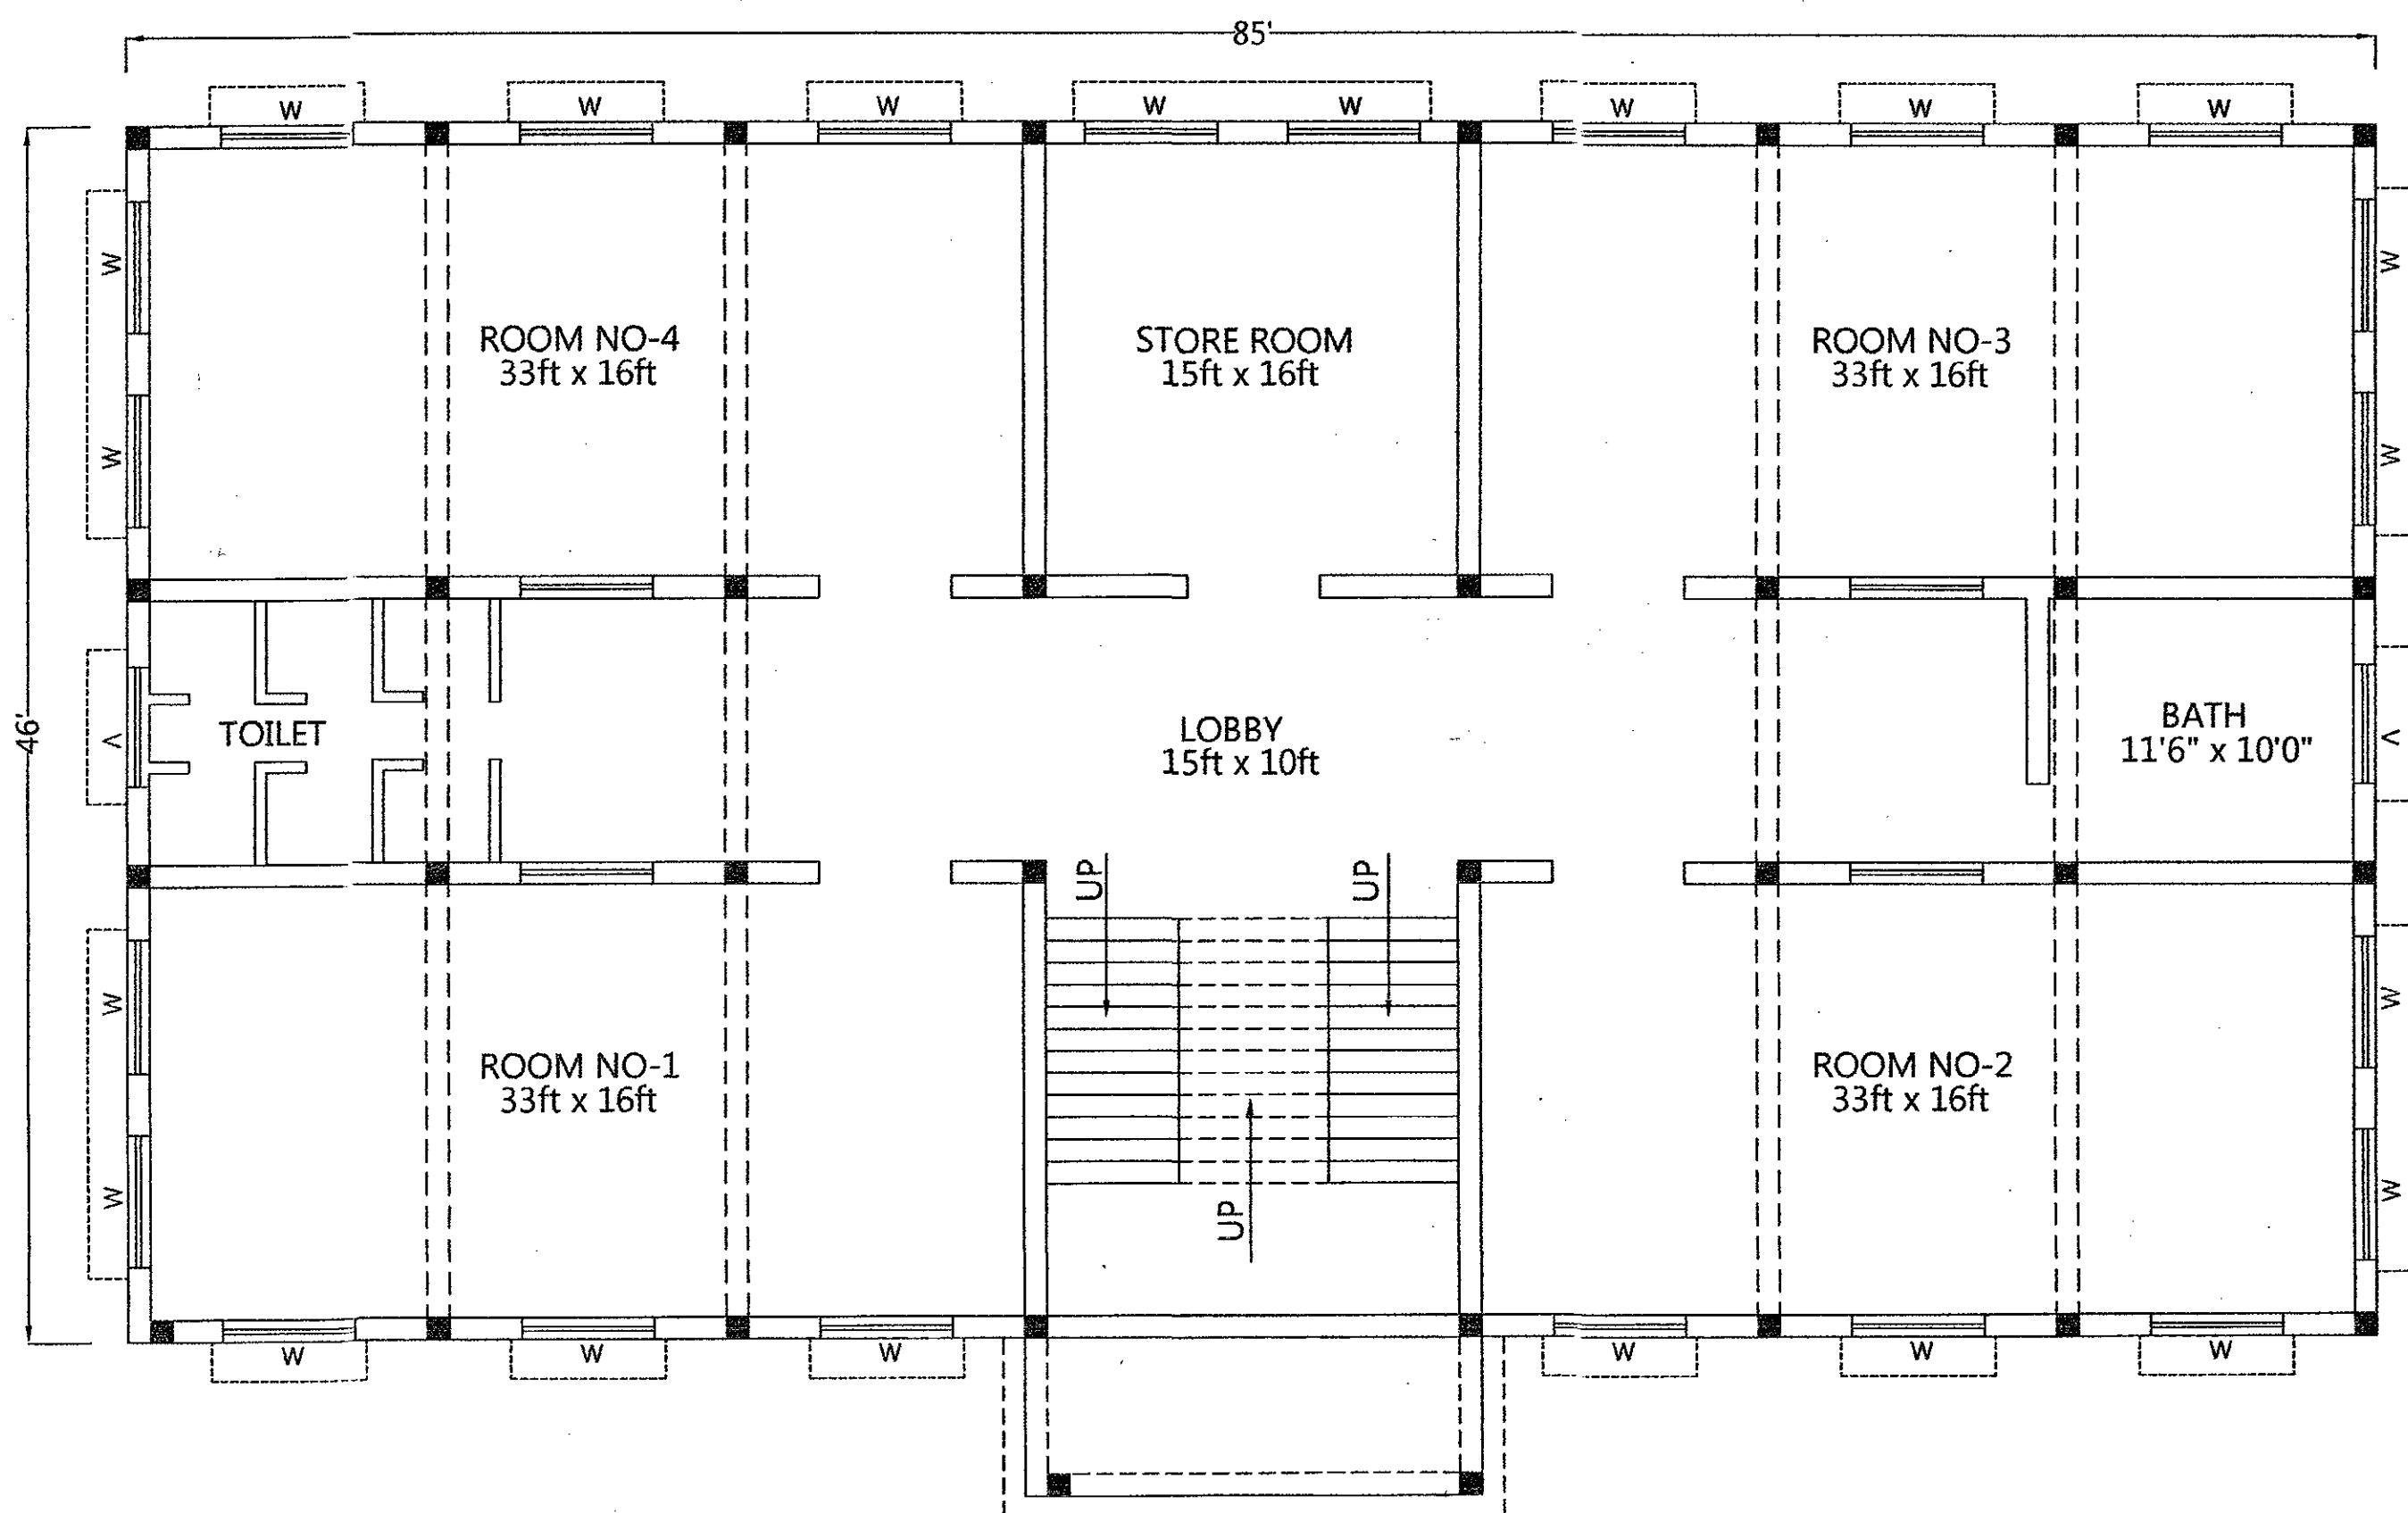


FIRST FLOOR PLAN FOR B.P.Ed

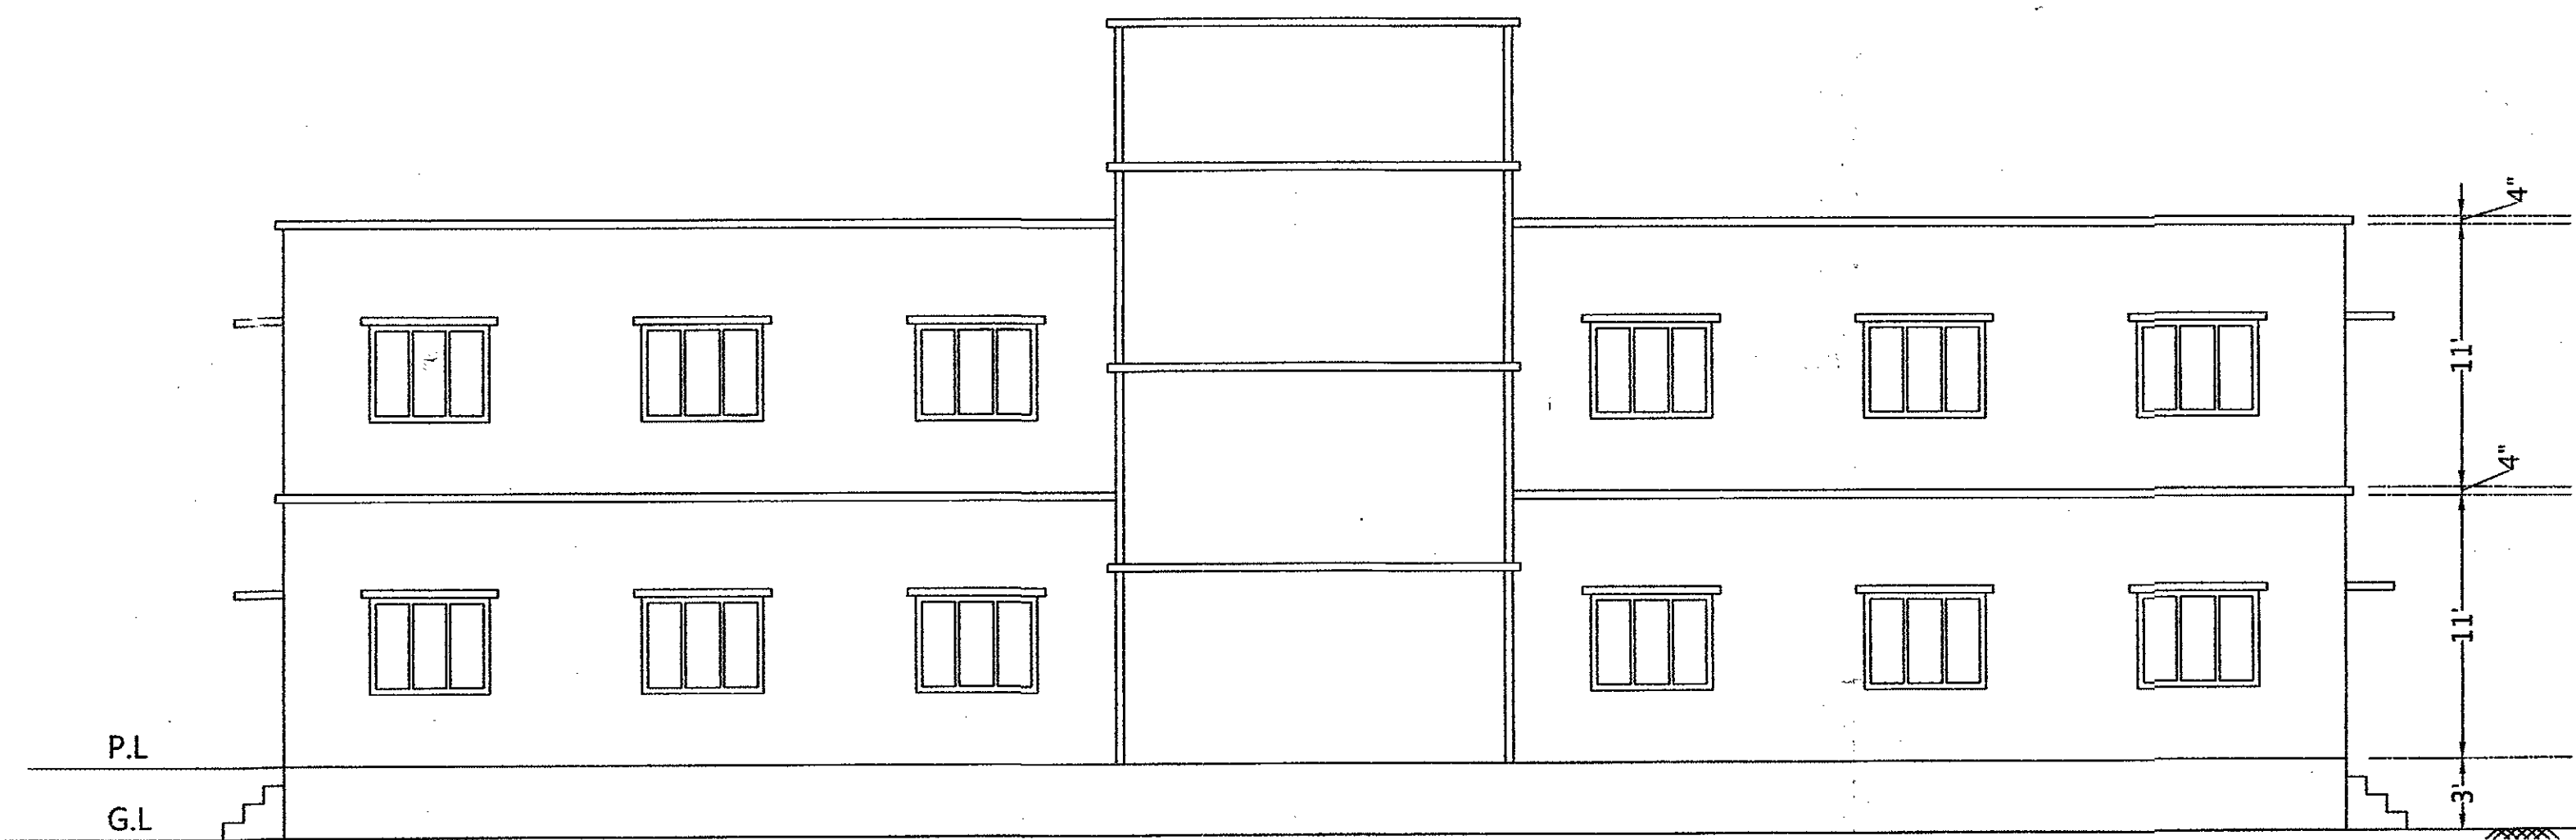

FRONT ELEVATION PLAN

*Khata no-67 (B.P.Ed)
Plot no - 250, H.M.C. Road - Tigiria
Total Area of Plot - 2250 Sq.ft
on 1/4th - 2250 Sq.ft
Total Area of Plot - 2250 Sq.ft
on 1/4th - 2250 Sq.ft
Total Area of Plot - 6000 Sq.ft
on 1/4th - 325 Sq.ft
on 1/4th - 6000 Sq.ft
Total Area of Plot - 1000 Sq.ft
on 1/4th - 1000 Sq.ft*

*Er. A. Mohapatra
19/12
2013*

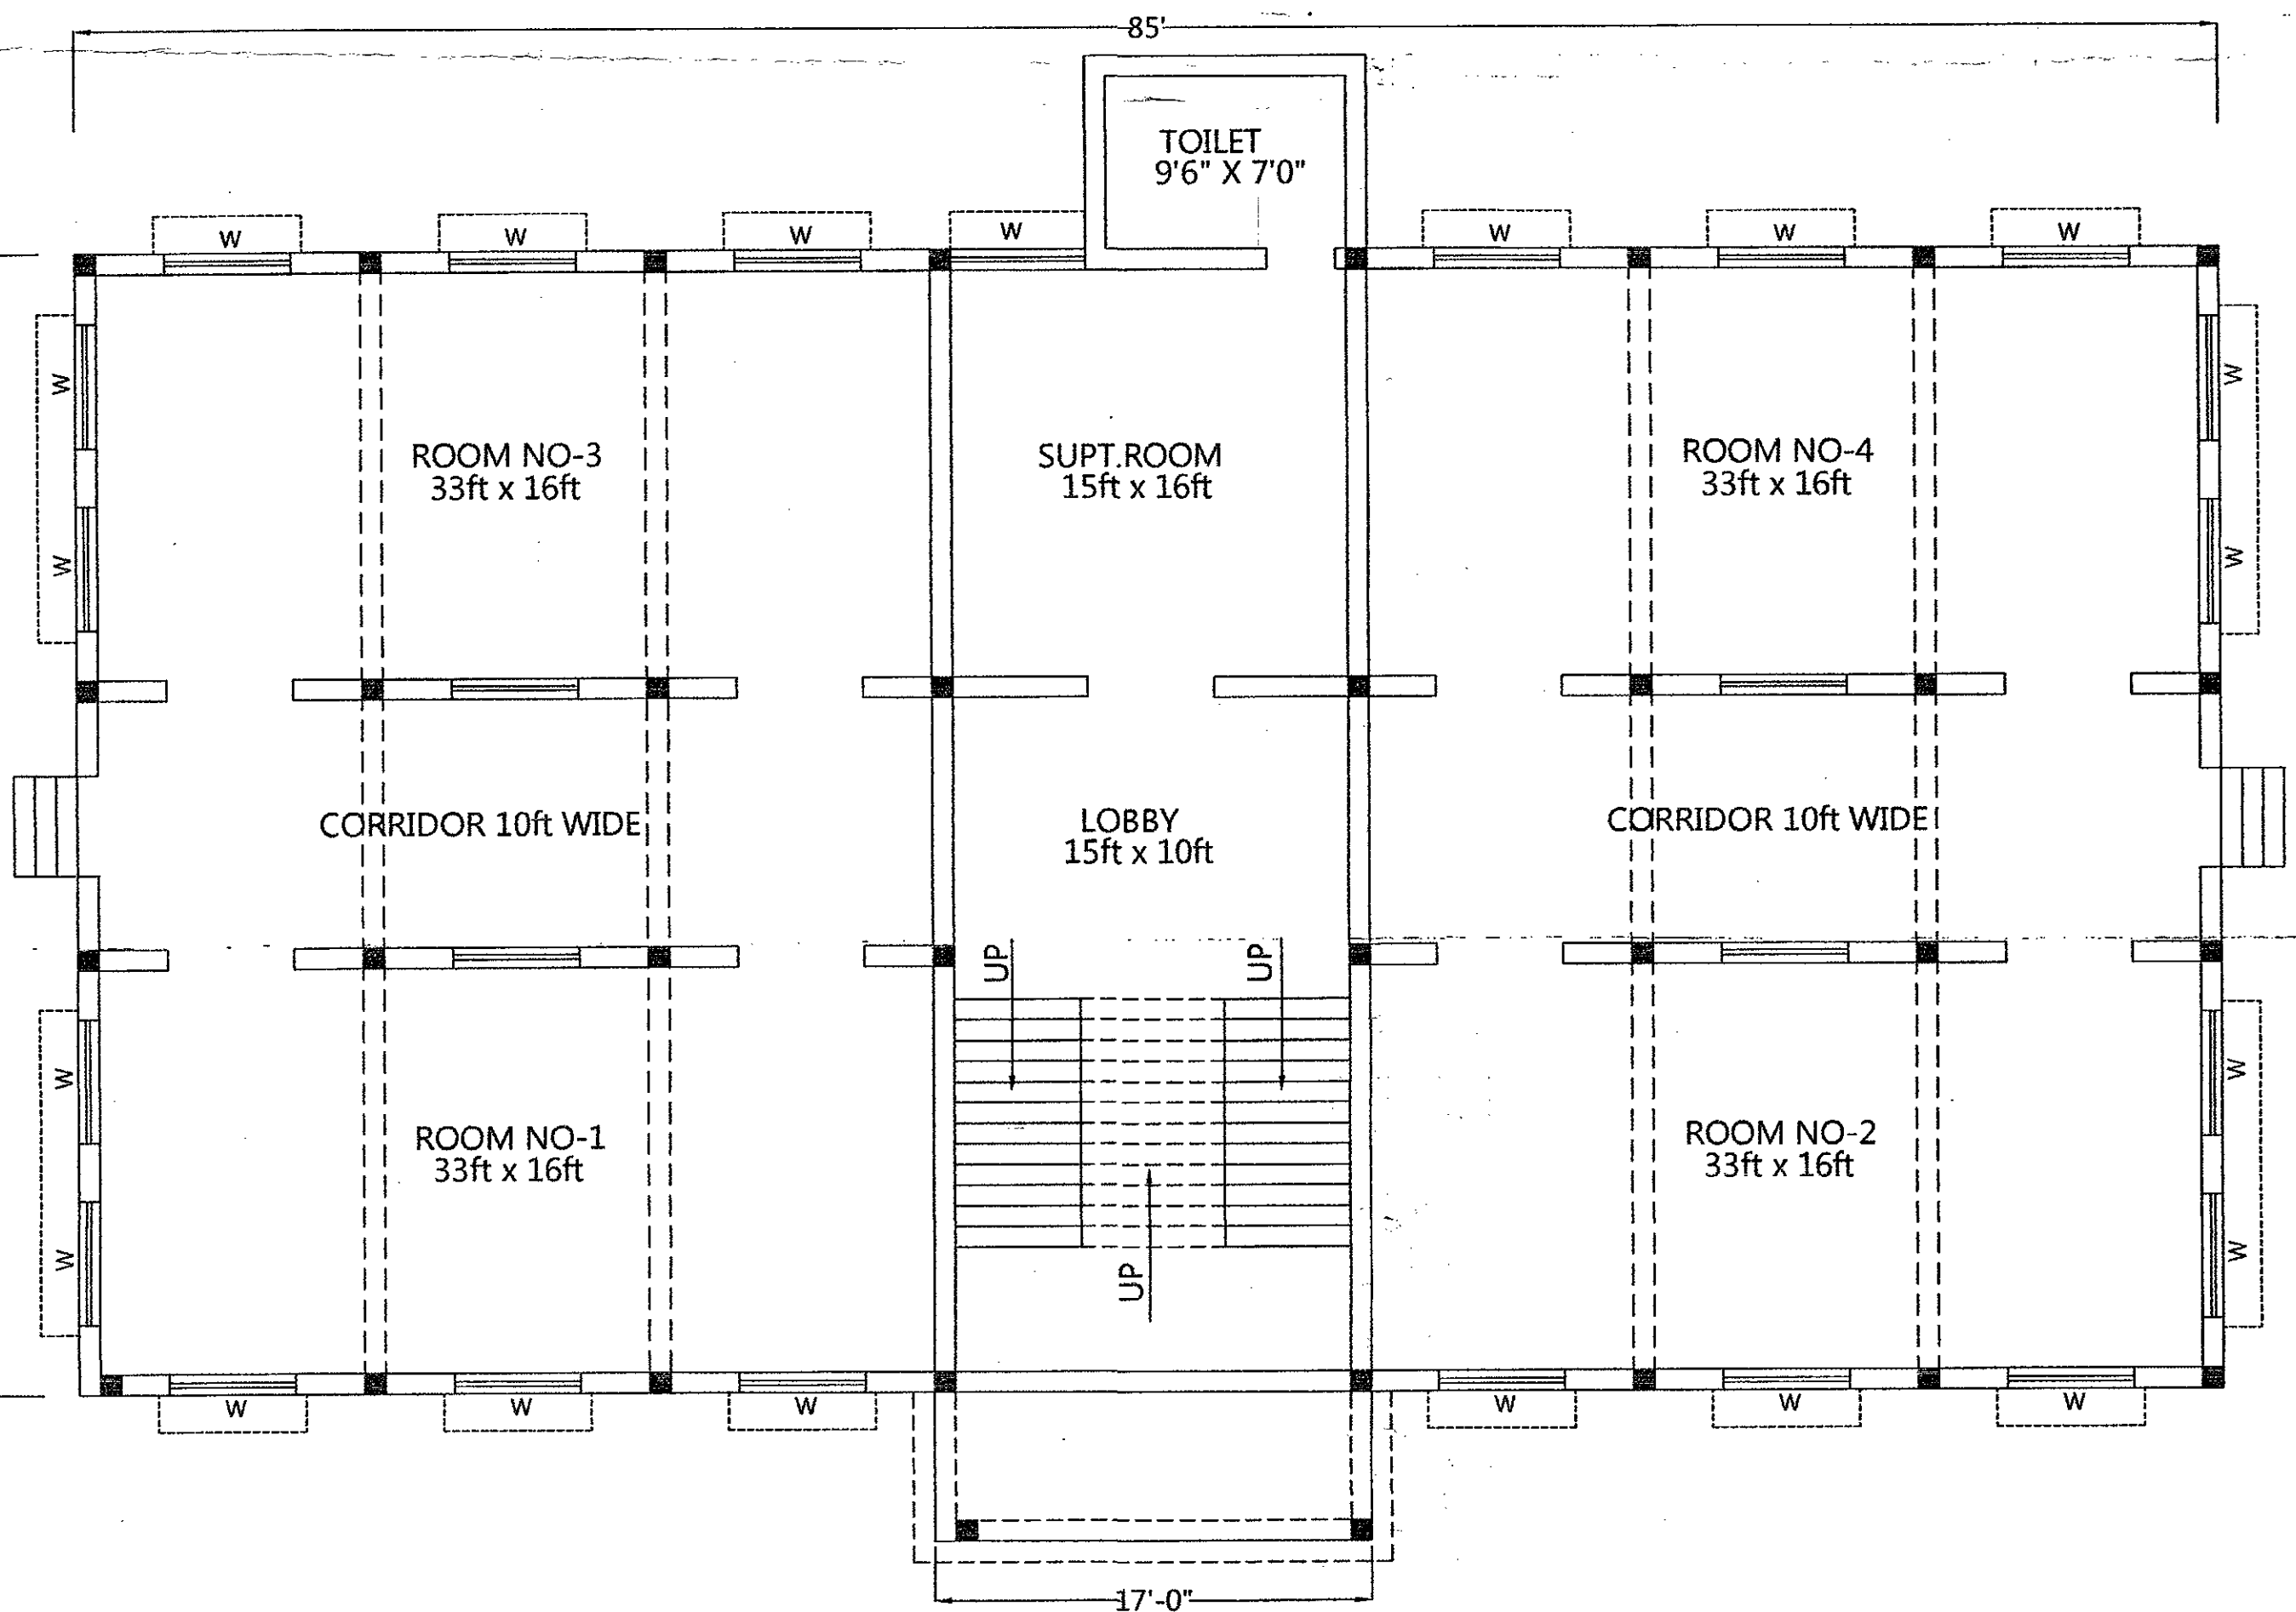

GROUND FLOOR PLAN FOR C.P.Ed

NAME OF THE CONSULTANT-

SUVADRA
CONSULTANTS

(Approved by Govt. of Odisha.) (An ISO 2000:2008 Certified.)
Soil Testing Laboratory & Engineering Consultant.
REGD. OFF. - PP-97, Tankapuri Road Bhubaneswar-751018, Odisha.
Phone-(0674)6536124 Fax-0674-2432090
E-mail-suvadra_consults@yahoo.com
Web - www.suvadraconsultants.com


PROJECT TITLE:-

AS BUILT PLAN OF BLOCK NO-2 FOR PRASANMANI
COLLEGE OF PHYSICAL EDUCATION AND YOGA AT TIGIRIA


Drawn By:-
Er. A. Mohapatra

Checked By:
[Signature]


Certified by building

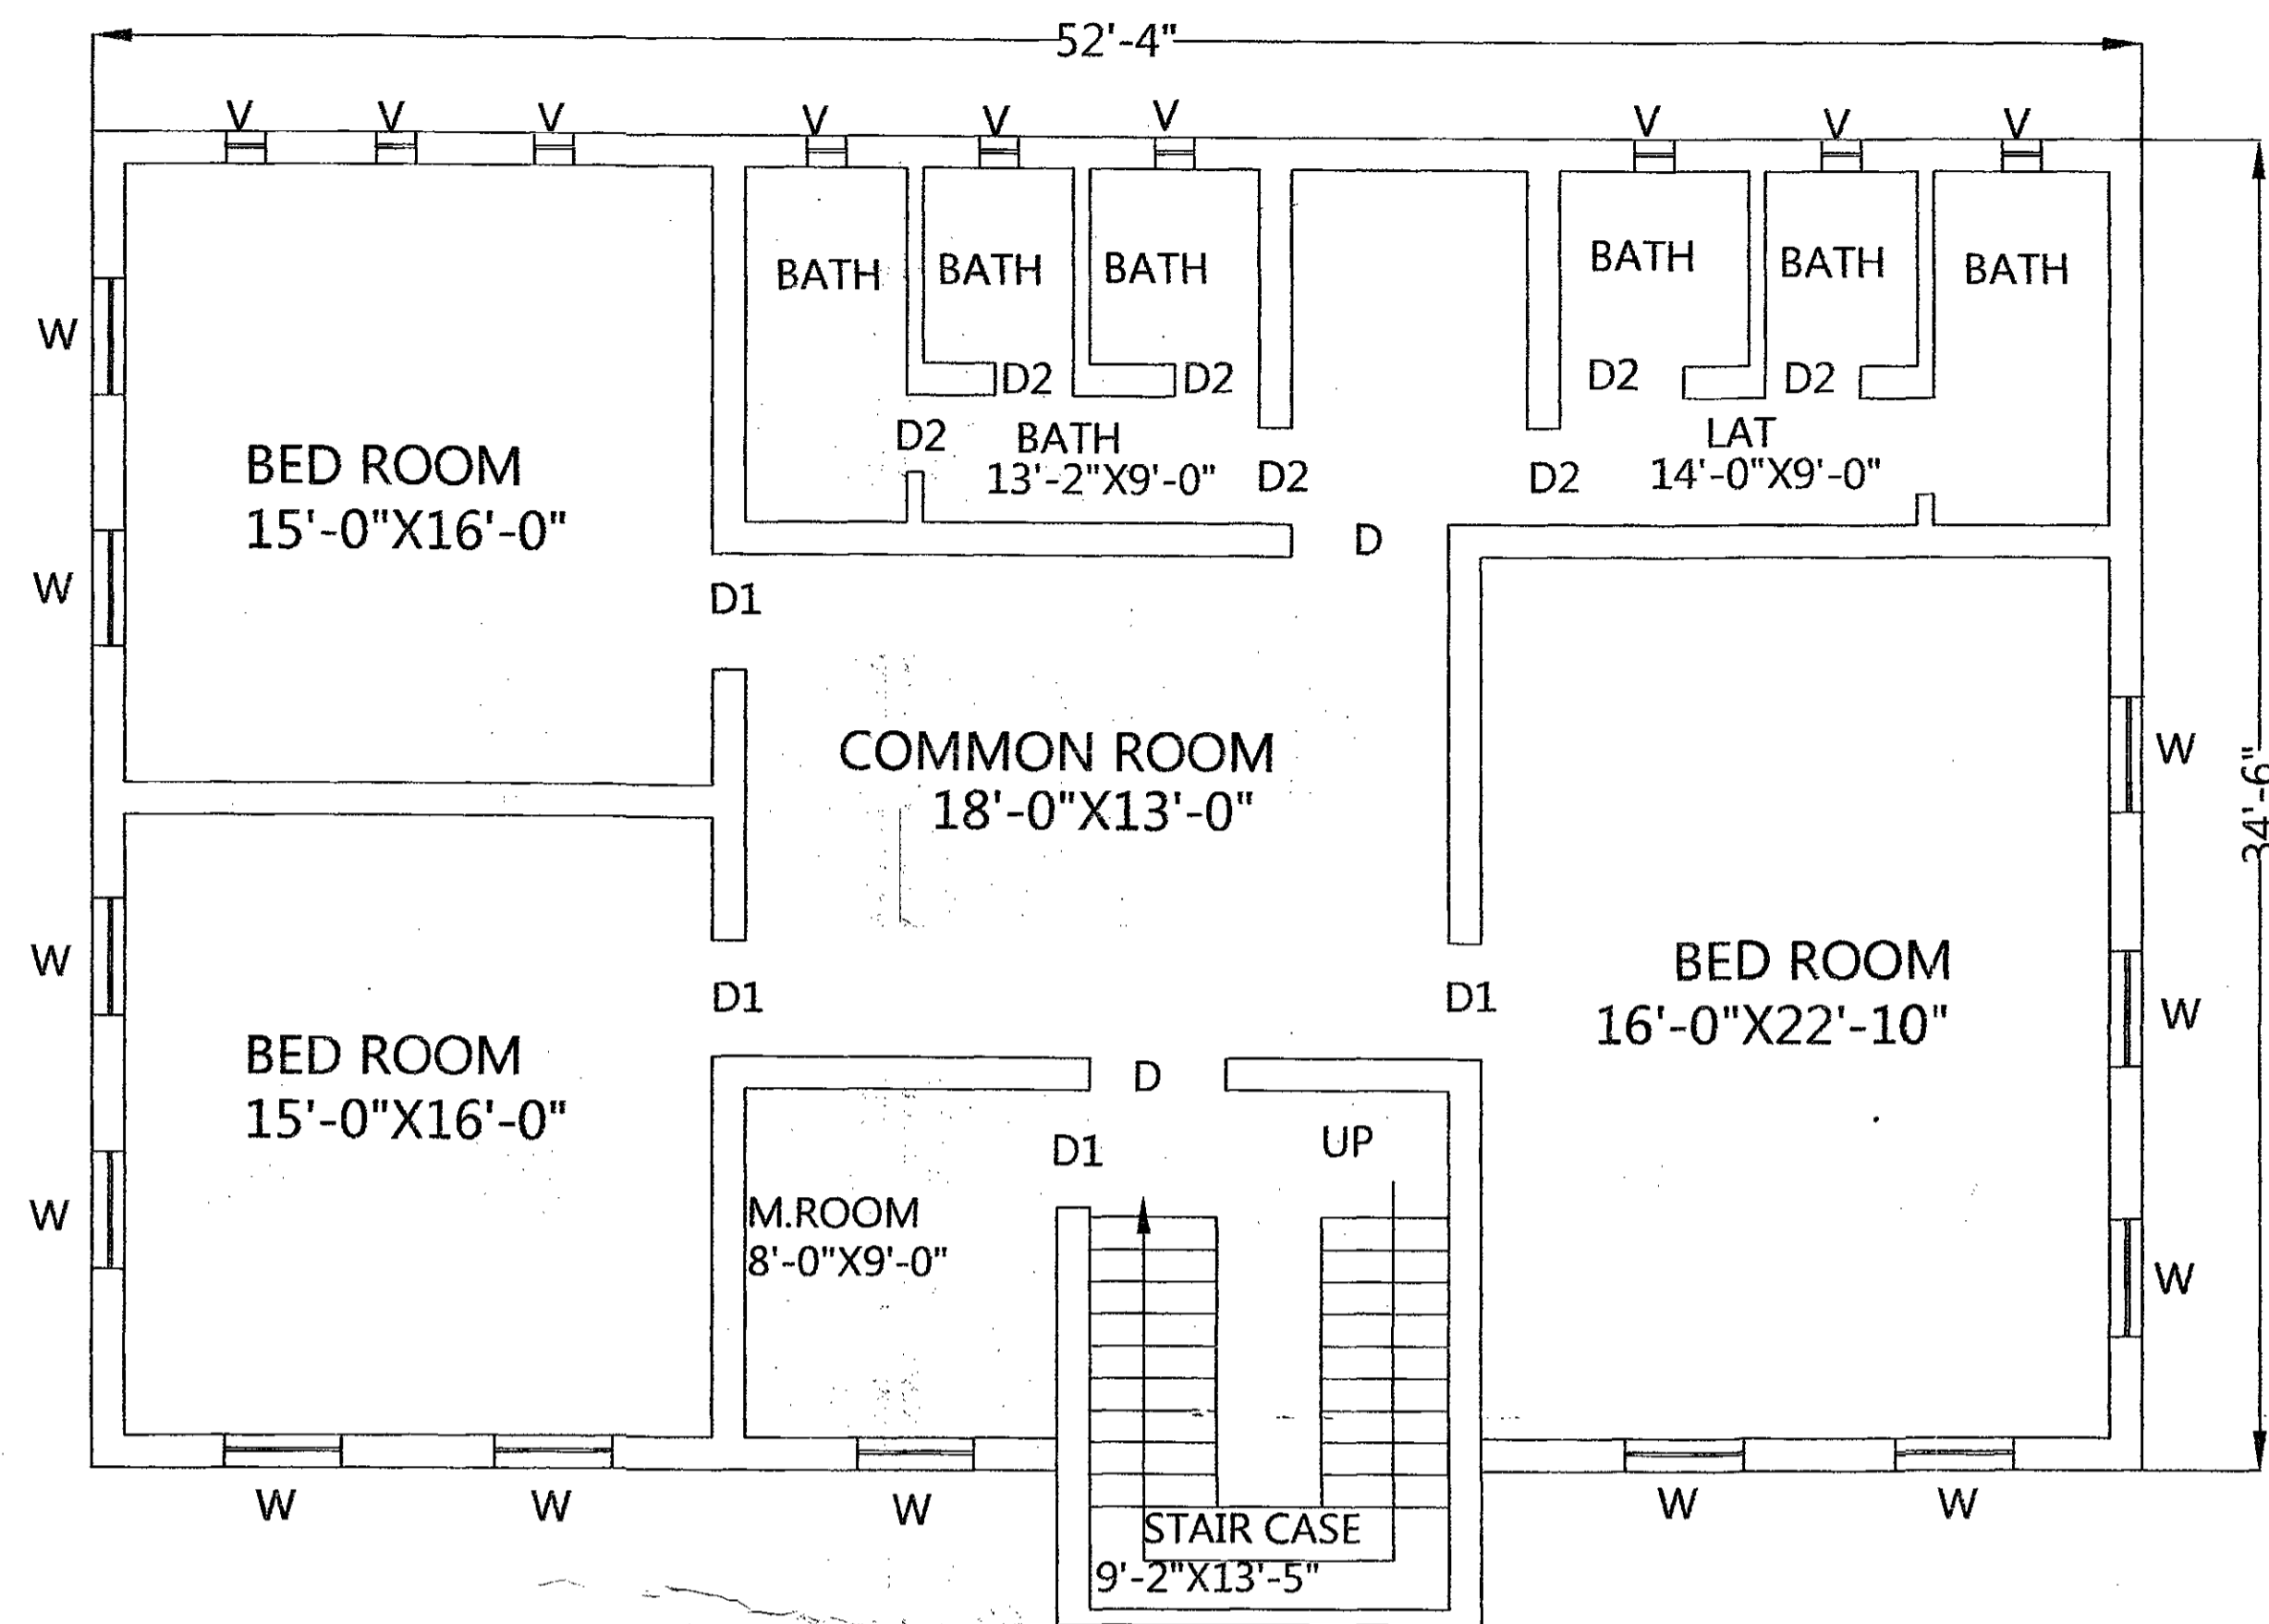

PROPOSED FOR USE B.P.Ed COURSE
 FIRST FLOOR PLAN

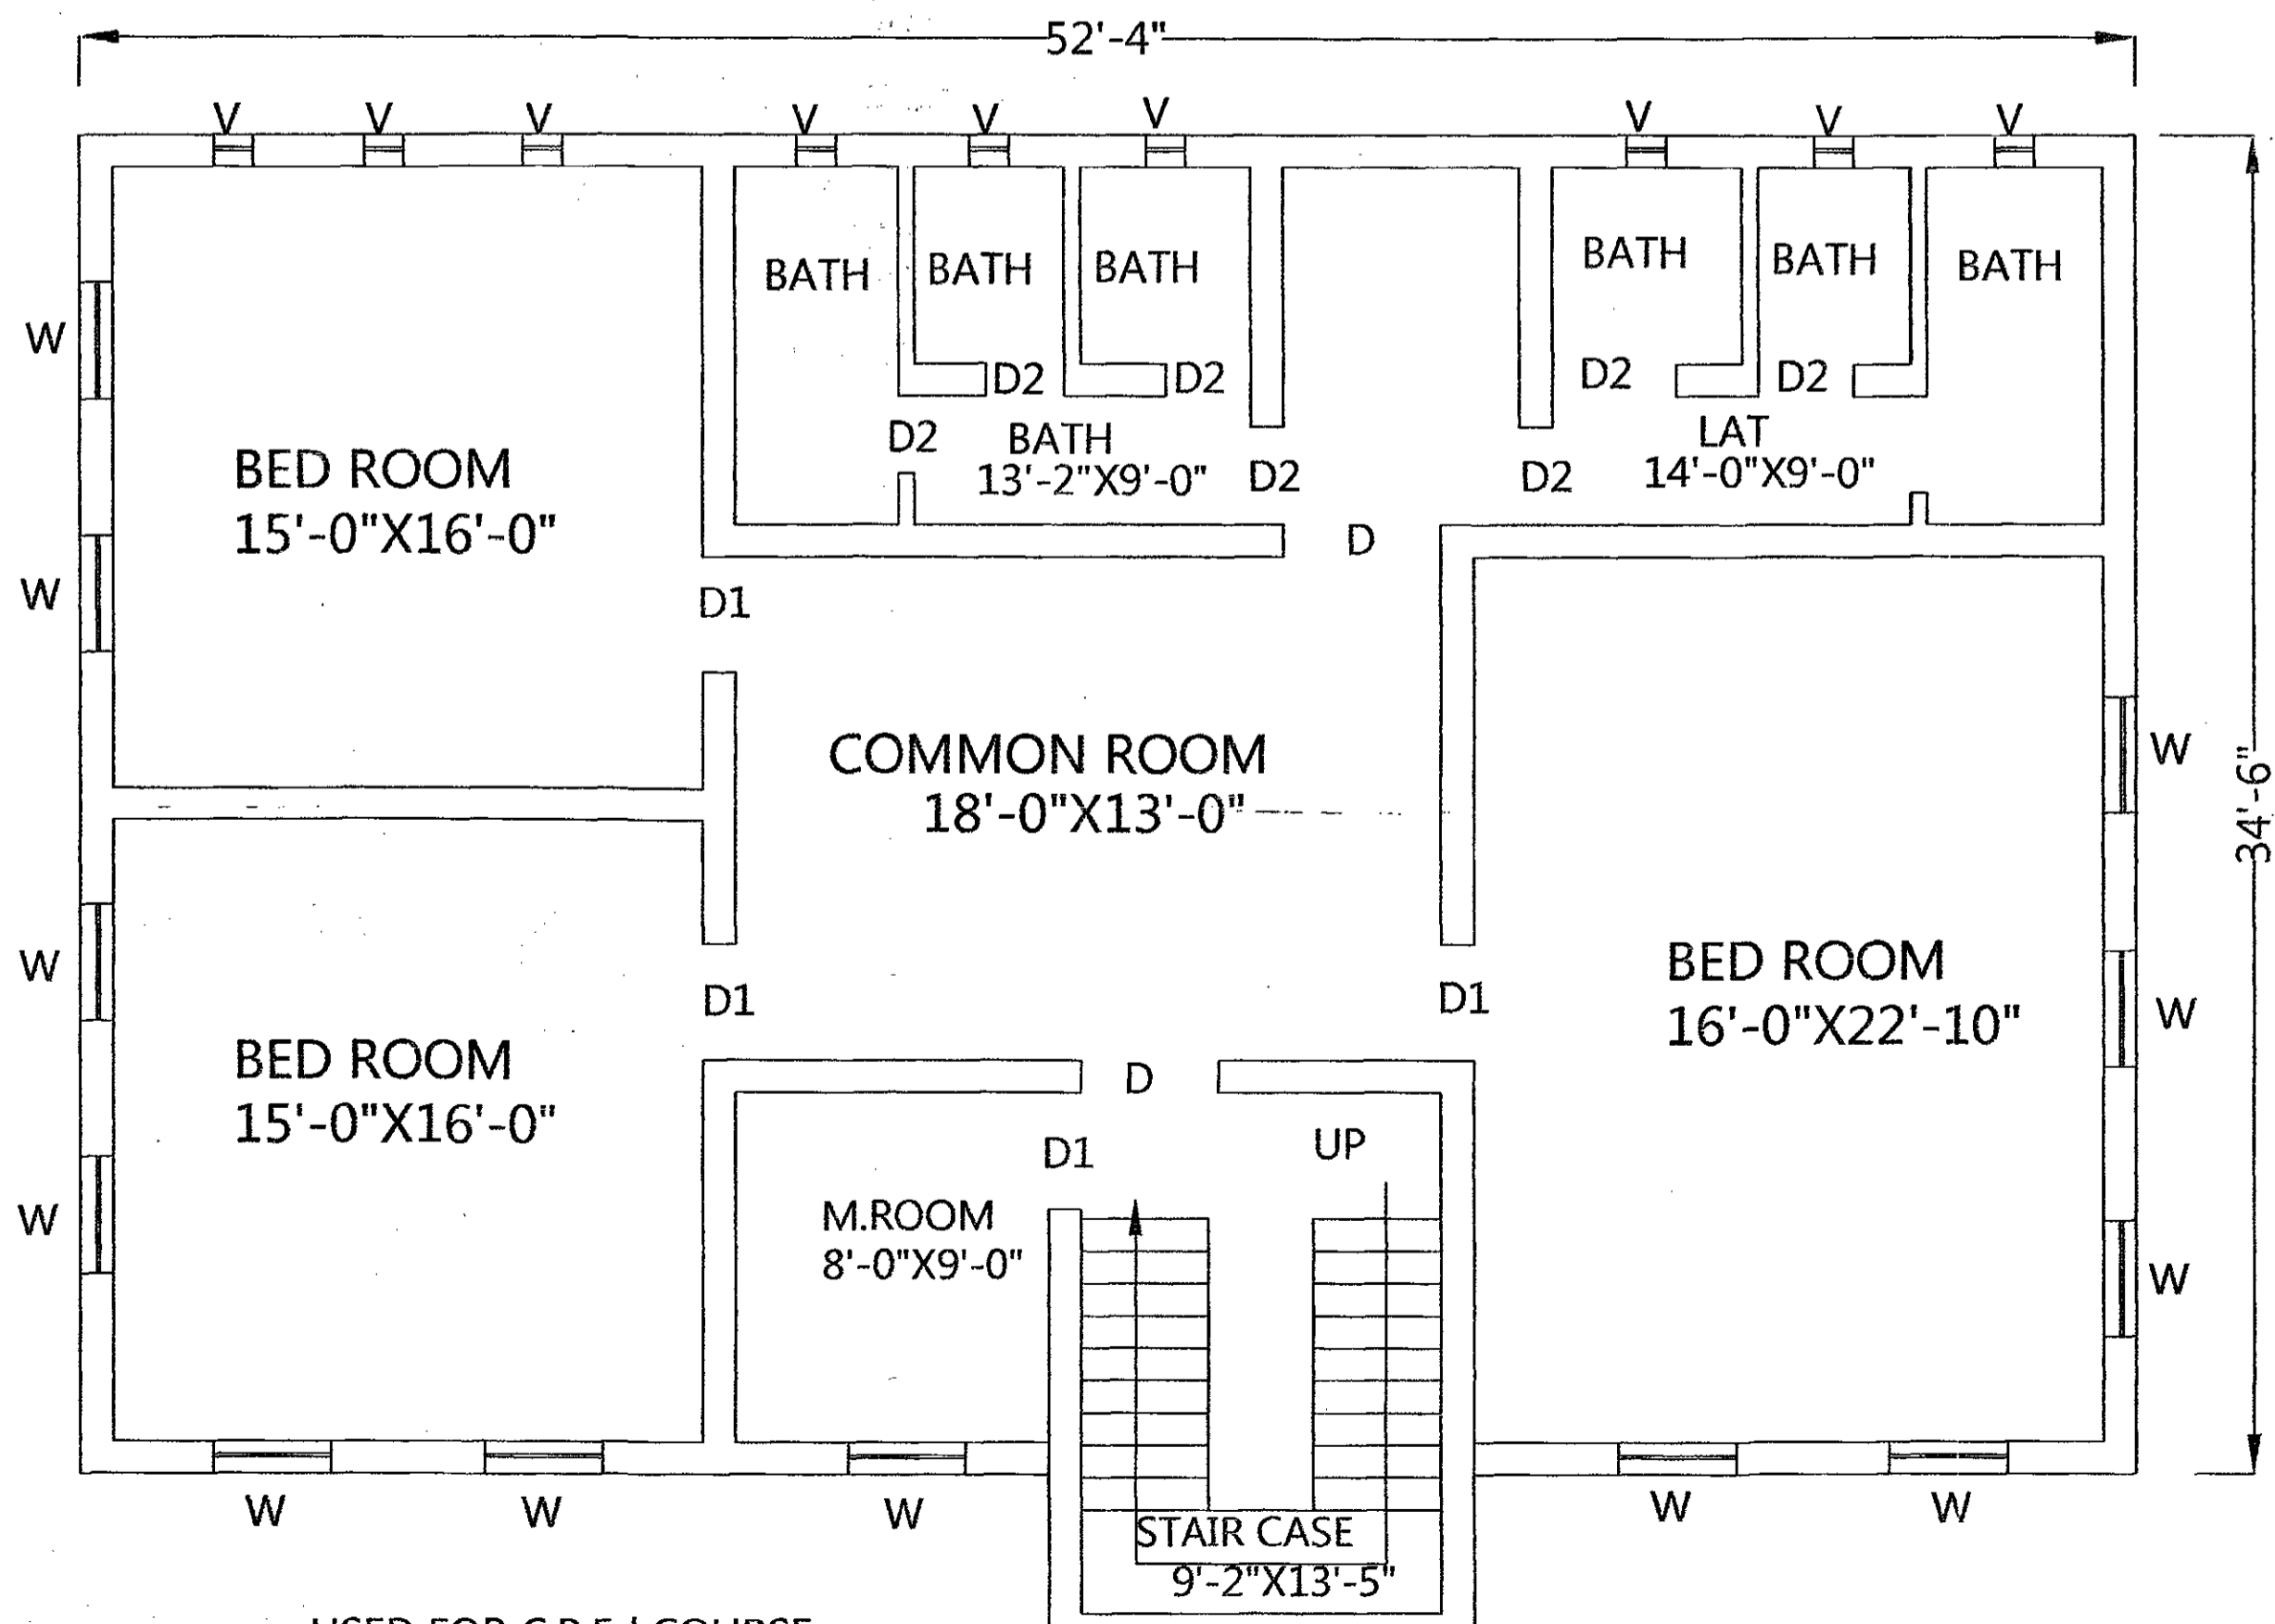

USED FOR C.P.Ed COURSE
 GROUND FLOOR PLAN

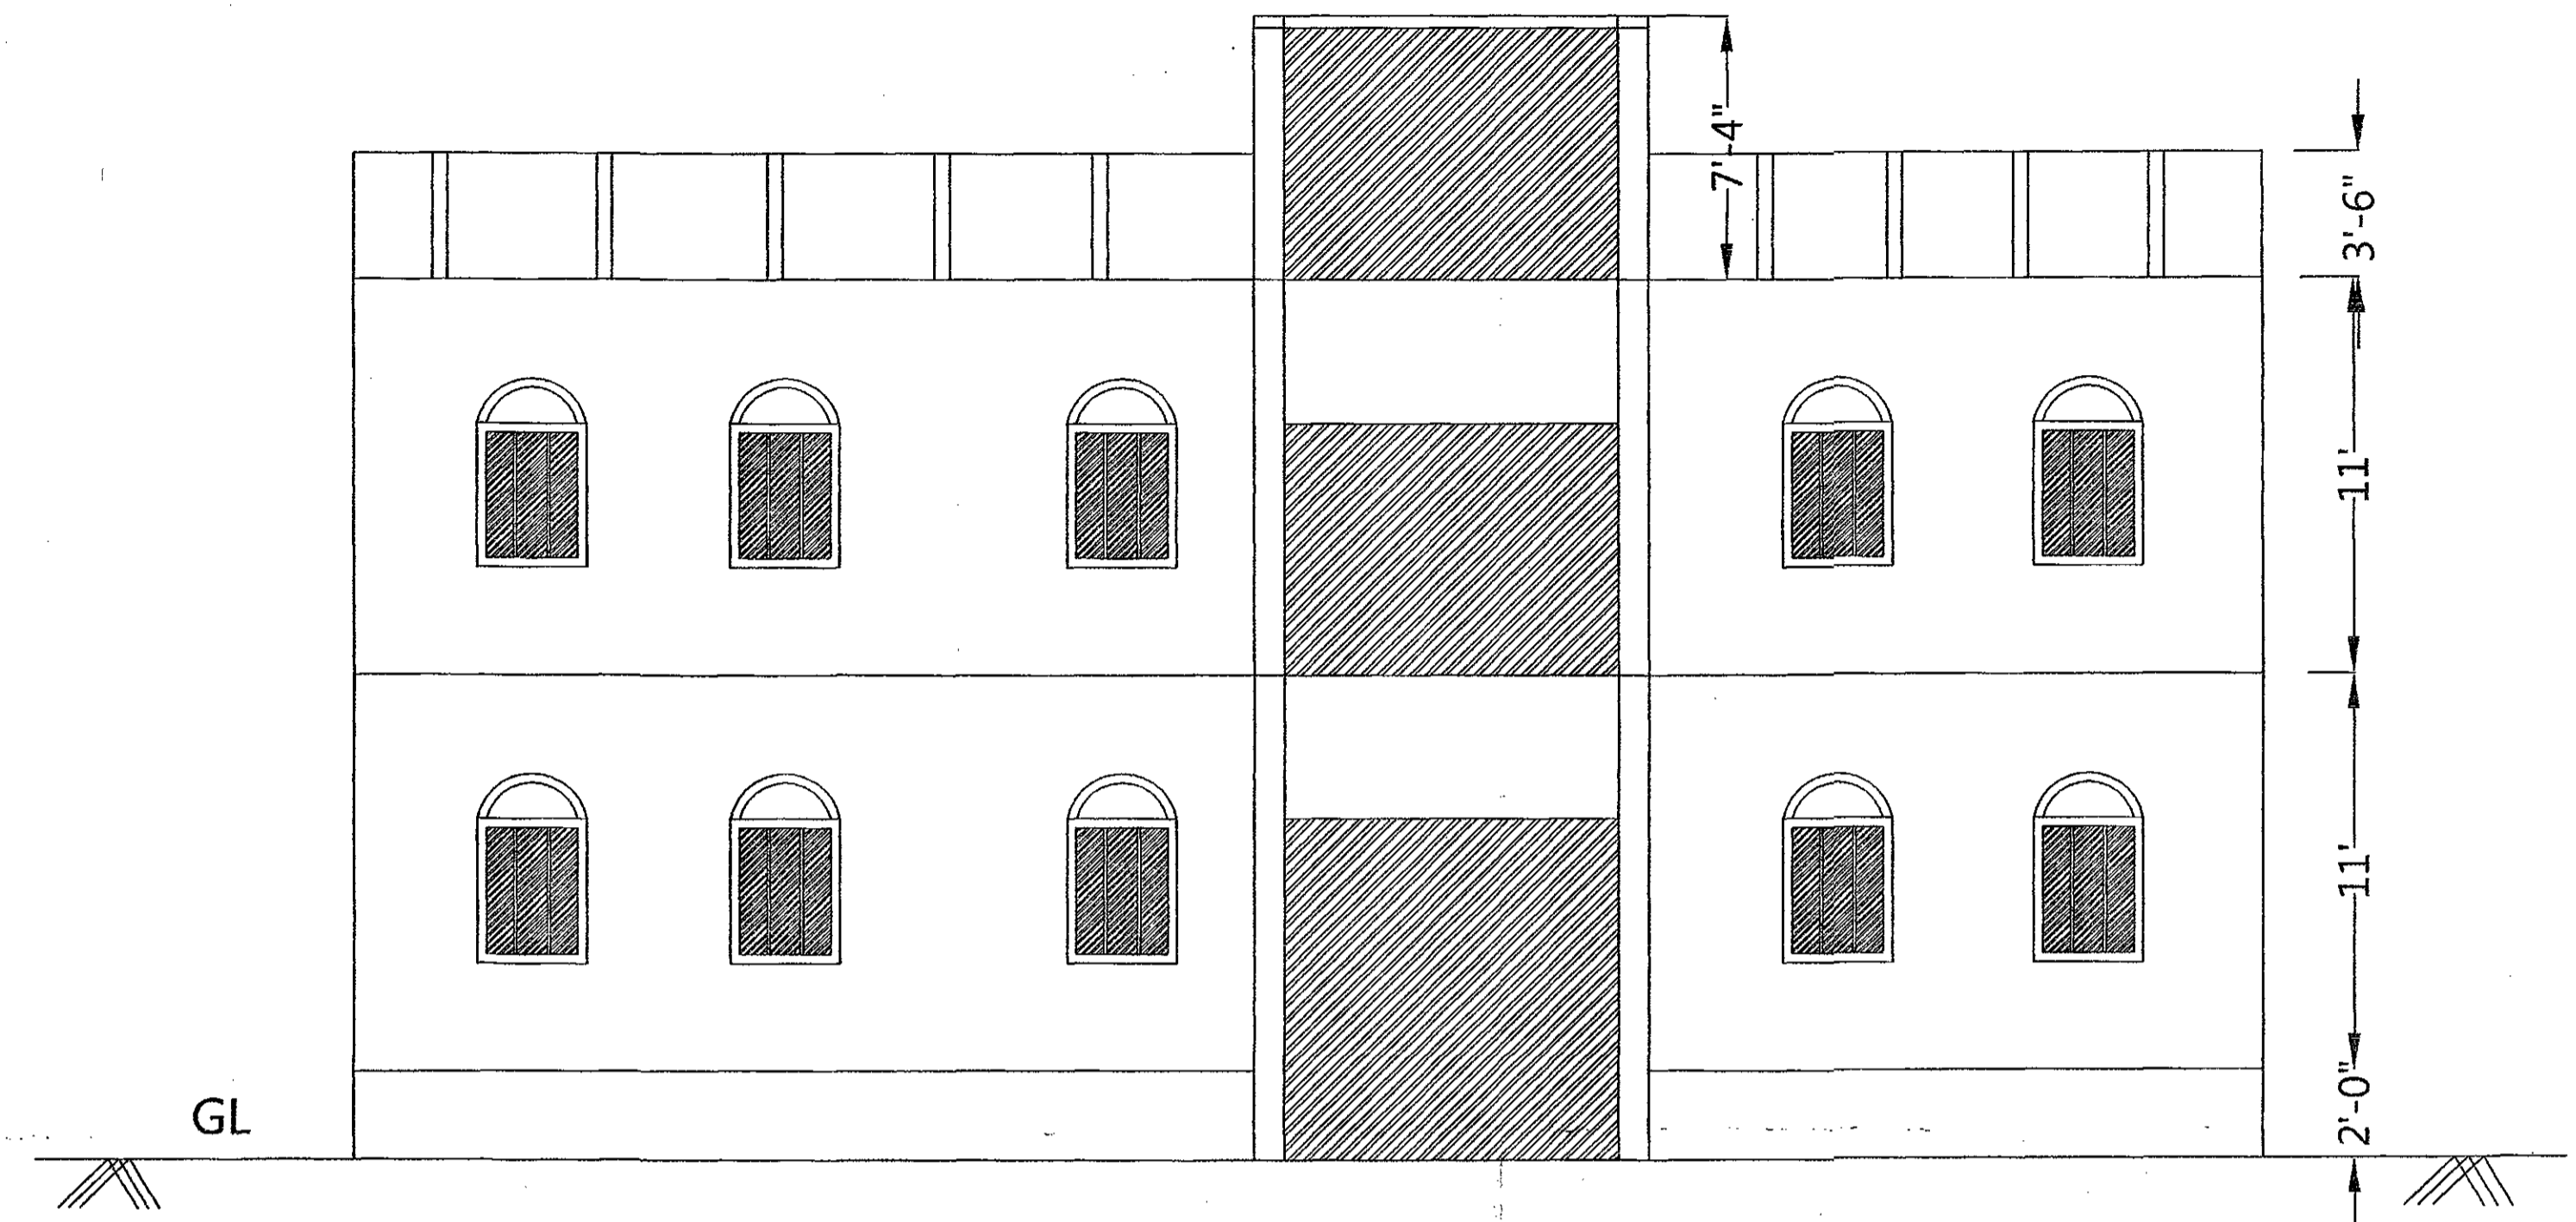

*Kh. No. 361/281 (29200)
 Plot No. 74/289 - 10.12.2008
 Total area of plot - 5200 sqft
 Area of 1st floor - 1820 sqft
 Area of 2nd floor - 1820 sqft
 Area of 3rd floor - 1820 sqft
 Total area of 3 floors - 5460 sqft
 The building is situated
 at above plots.*

*Sudhakar
 6/19/13*

NAME OF THE CONSULTANT:-

SUVADRA
 CONSULTANTS


(Approved by Govt. of Odisha.) (An ISO 2000:2008 Certified.)
 Soil Testing Laboratory & Engineering Consultant.
 REGD. OFF.-PP-97, Tankapani Road Bhubaneswar-751018, Odisha.
 Phone-(0674)6536124 Fax-0674-2432090
 E-mail-suvadra_consults@yahoo.com
 Web - www.suvadraconsultants.com

PROJECT TITLE:-


AS BUILD DRAWING BLOCK NO - 3
 BUILDING OF PRASANMANI COLLEGE OF
 PHYSICAL EDUCATION AT/- TIGIRIA, CUTTACK

Drawn By:-
 Er. A. Mohapatra


Checked By:-
 Er. B. K. Janga

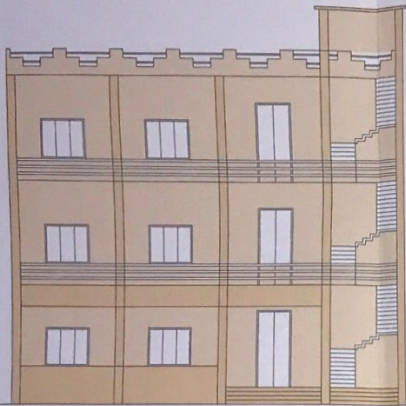


FRONT ELEVATION

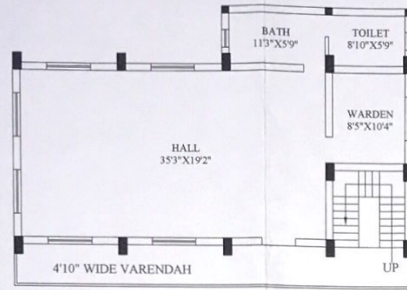


FIRST & SECOND FLOOR PLAN

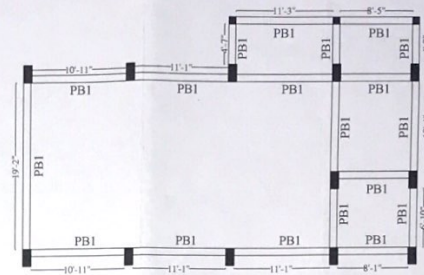


PLINTH BEAM LAYOUT

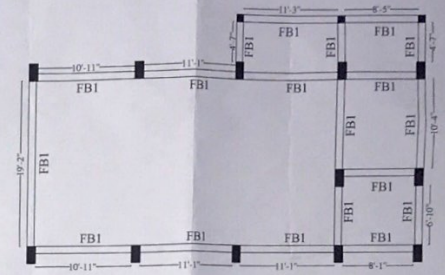


FIRST FLOOR BEAM LAYOUT

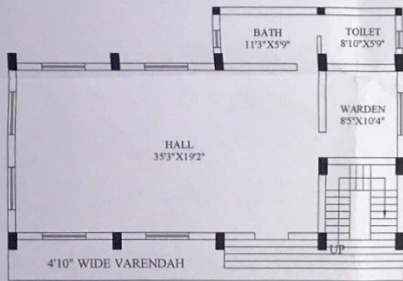


GROUND FLOOR PLAN

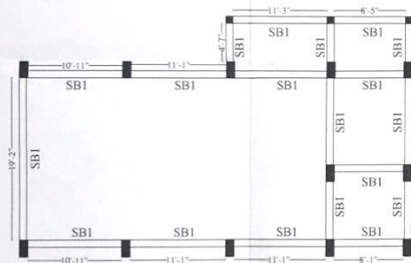


SECOND FLOOR BEAM LAYOUT

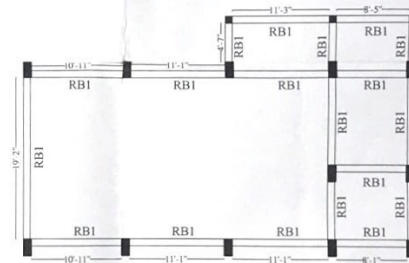


ROOF BEAM LAYOUT

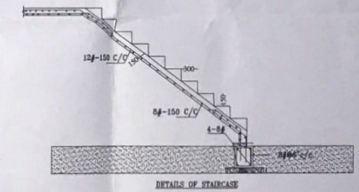


DETAIL OF STAIRCASE

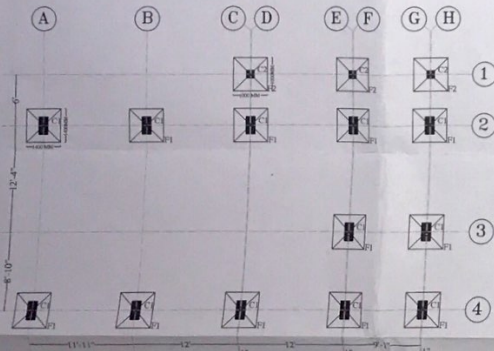


COLUMN - FOOTING LAYOUT

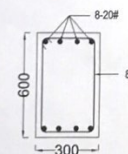


COLUMN C1

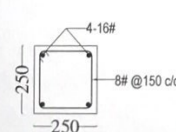


COLUMN C2

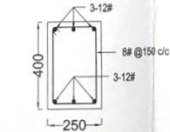


PLINTH BEAM

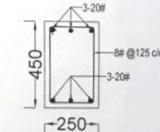


SECTION OF FB1

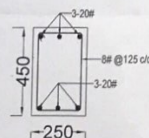


SECTION OF SB1

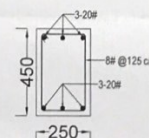


SECTION OF RB1

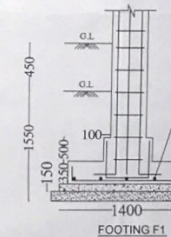

FOOTING F1

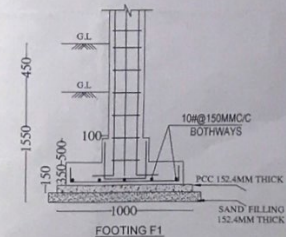

FOOTING F1

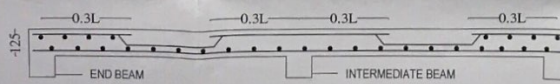

DETAILS OF SLAB

PROJECT TITLE:-
CONSTRUCTION OF CANTEEN BUILDING FOR
PRASSANAMANI COLLEGE OF PHYSICAL
EDUCATION AND YOGA.

NAME OF THE CONSULTANT:-

SUVADRA
CONSULTANTS



(Approved by Govt. of Odisha.) (An ISO 2000:2008 Certified)
Soil Testing Laboratory & Engineering Consultant
REGD. OFF. - PP-97, Tankapani Road Bhubaneswar - 751 018, Odisha
Phone-(0674)6536124 Fax-0674-2432090
E-mail-suvadra_consults@yahoo.com
Web - www.suvadraconsultants.com

Drawn By:- Er. Sushri Sangita

Checked By:- Er. B. K. Tunga

Junior Engineer
Tigiria Block


BLOCK NO.-5 MULTIPURPOSE HALL

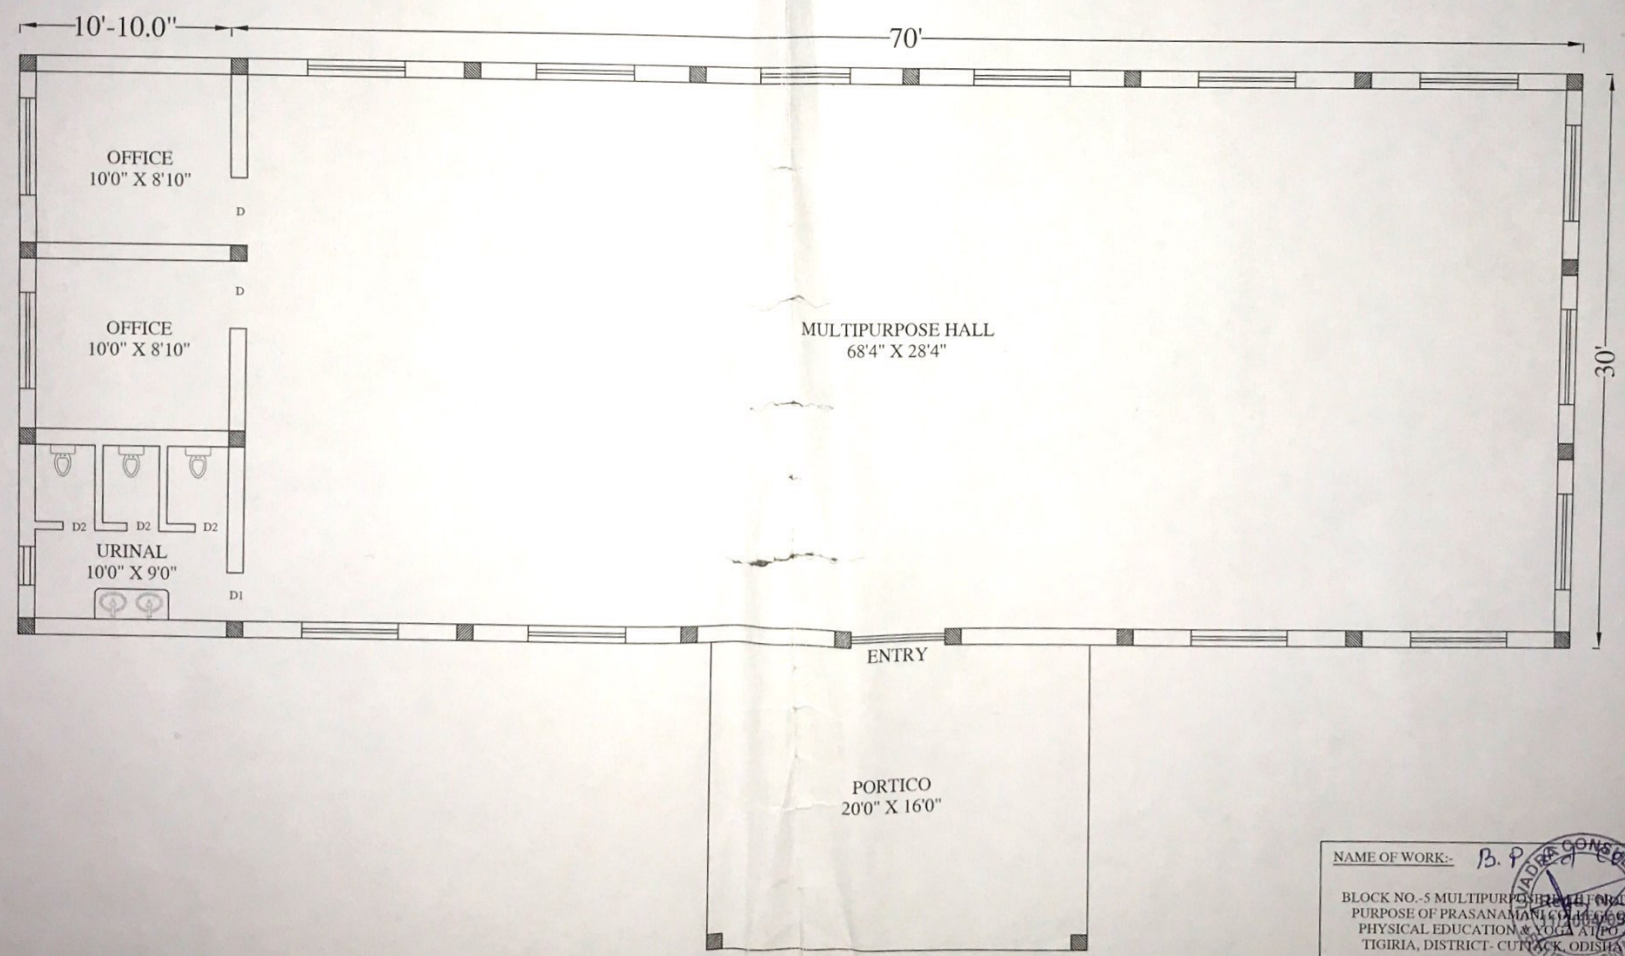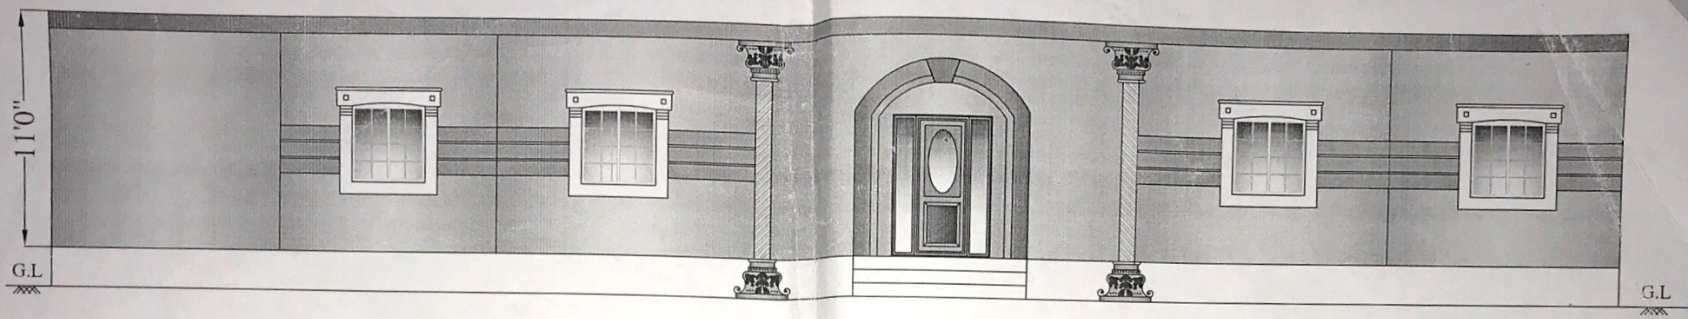


NAME OF WORK:- B. P. *Consense*

BLOCK NO.-5 MULTIPURPOSE HALL FOR THE
 PURPOSE OF PRASANAMANIC AND YOGA
 PHYSICAL EDUCATION & YOGA A/PO
 TIGIRIA, DISTRICT- CUTTACK, ODISHA


APPROVED
 CONSENSE

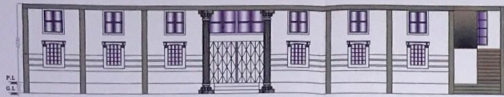


FRONT ELEVATION

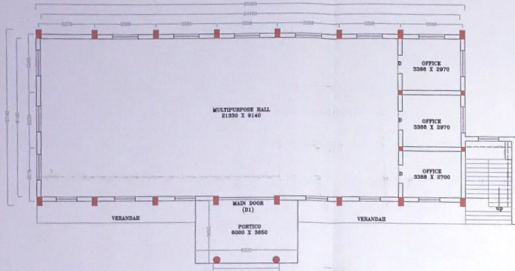

PLAN

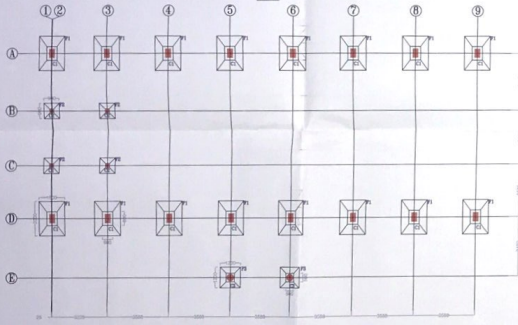

COLUMN - FOOTING LAYOUT

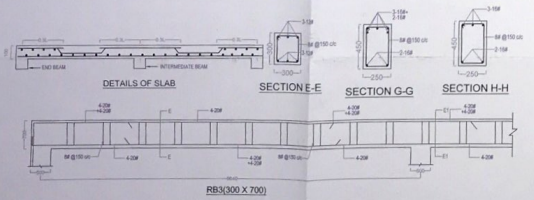


DETAILS OF SLAB

SECTION E-E

SECTION G-G


SECTION H-H

RB3(300 X 700)

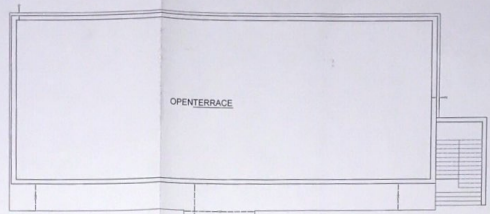


OPENTERRACE

ROOF BEAM LAYOUT

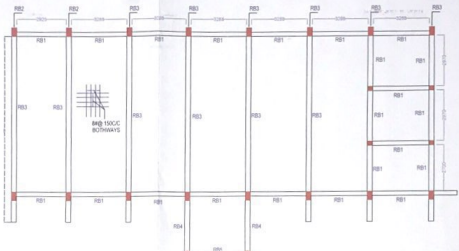

ROOF BEAM LAYOUT

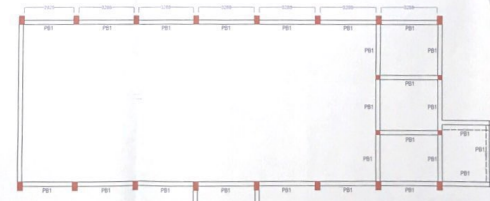


PLINTH BEAM LAYOUT

RB(250 X 400)

RB4(300 X 300)

RB(300 X 450)

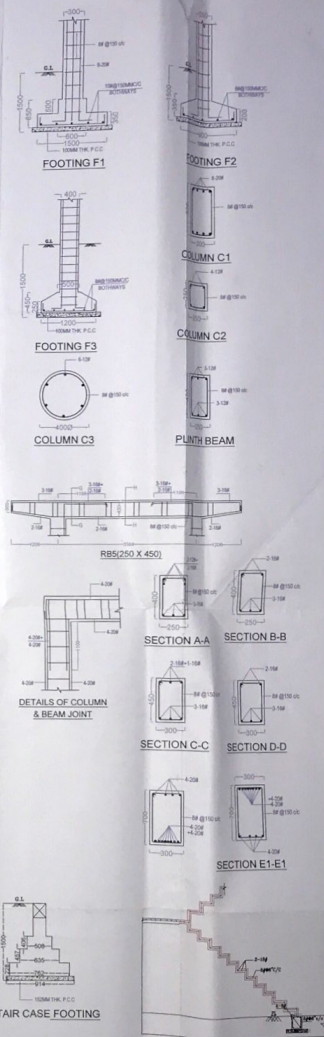

FOOTING F1

FOOTING F2

FOOTING F3

COLUMN C1

COLUMN C2

COLUMN C3

PLINTH BEAM

RB5(250 X 450)

SECTION AA

SECTION B-B

SECTION C-C

SECTION D-D

SECTION E1-E1

STAIR CASE FOOTING

NOTES:

1. ALL DIMENSIONS ARE IN MM.
2. DRAWINGS SHOULD NOT BE SCALED, WRITTEN DIMENSION ONLY TO BE FOLLOWED.
3. GRADE OF CONCRETE = M-20
4. GRADE OF STEEL HYSD STEEL BARS CONFORMING TO IS-1786 OF GRADE FE-415 TO BE USED.
5. BOND LENGTH = 50D
6. CLEAR COVER TO BEAM = 25 MM COLUMN = 40MM, SLAB = 20MM
7. ANY DEVIATION FOUND IN THE DRAWING THE SAME MAY BE REFERRED TO CONSULTANT BEFORE EXECUTION.
8. BEARING CAPACITY OF SOIL IS ASSUMED TO BE 10T/M²
9. THIS IS DESIGNED FOR DOUBLE STOREY ONLY.

SECTION E-E

Drawn By: Er. SOUMYA
Checked By: Er. B. K. Tunga

PROJECT TITLE:
CONTRACTOR OF PERFORM MULTIPURPOSE HALL
PRASANNAM COLLEGE OF ENGINEERING, TECHNOLOGY
& RESEARCH, CHITTOOR


SANMUKH ENGINEERING CONSULTANTS

SUVADRA
CONSULTANTS

100, 10th Cross, 10th Stage, 10th Mile, Mysore Road, Bangalore - 560029
Ph: 98454 44444, 98454 44444
E: suvadra@rediffmail.com, suvadra@rediffmail.com

~~Boys Hostel Building~~
BOYS HOSTEL BUILDING FOR PRASANMANI COLLEGE OF PHYSICAL EDUCATION AND YOGA
AT TIGIRIA



SCALE 1" = 8'-0"

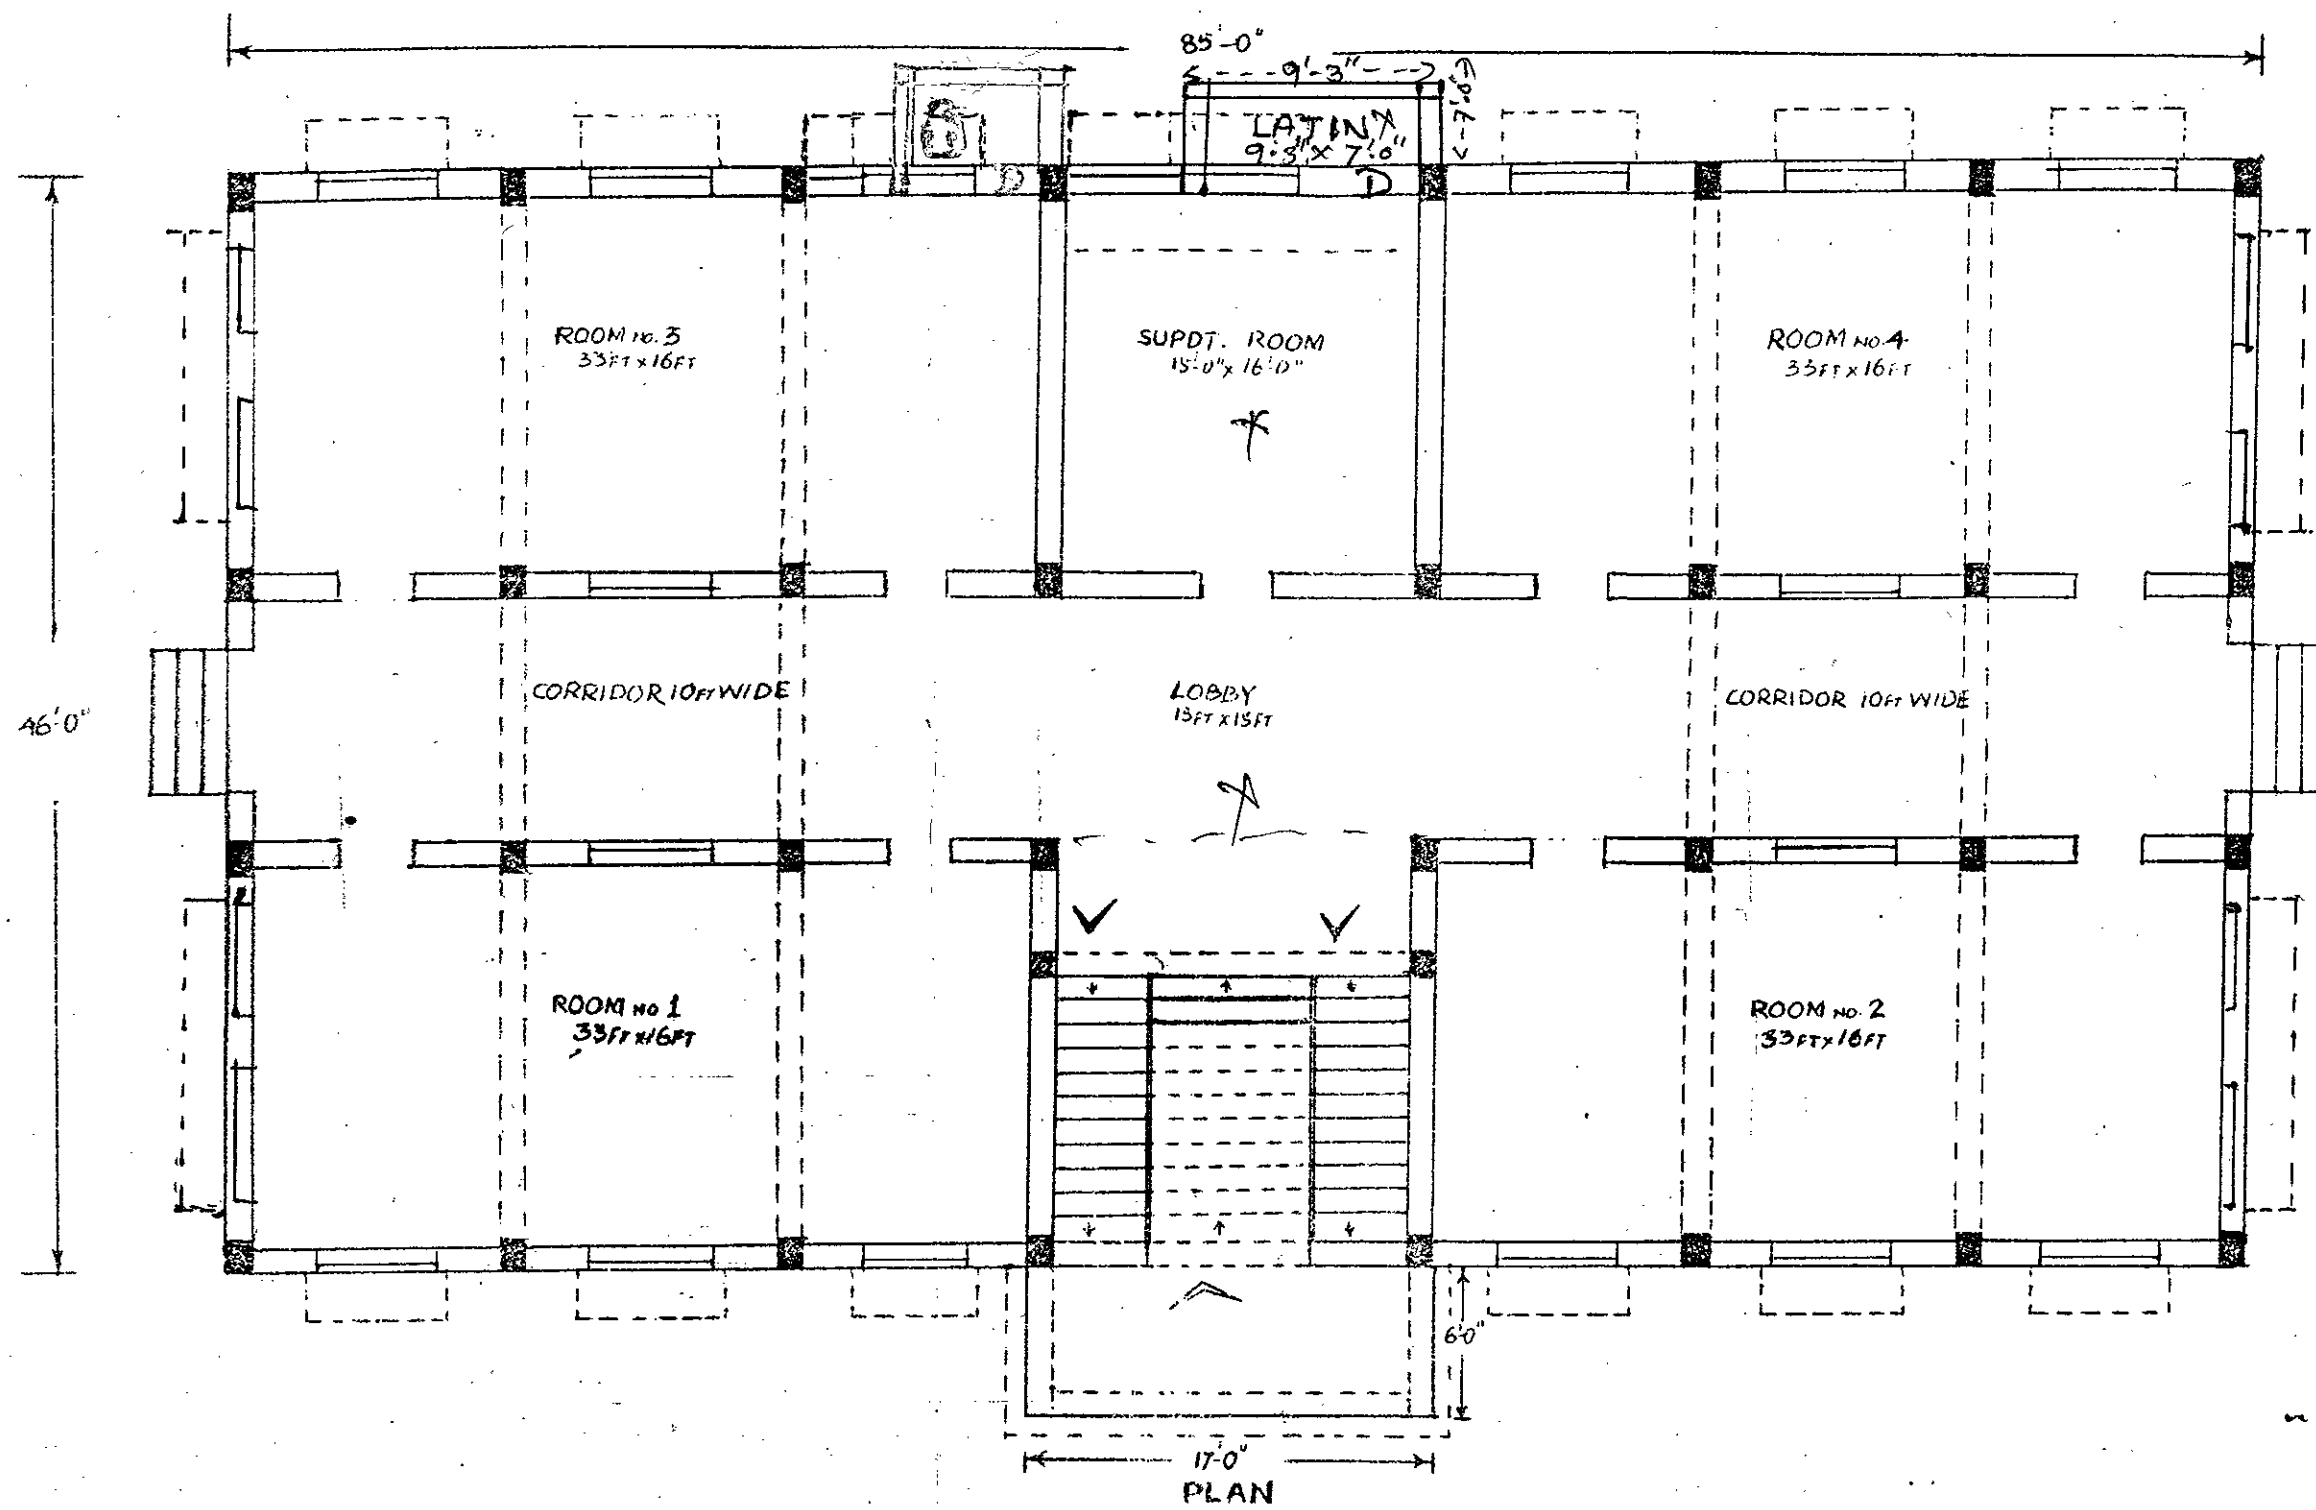

SCALE: 1" = 1 FT.

SCCHEDULE (G. FL.)


DOOR	SIZE	NOS	WIND.	SIZE	NOS
G	4' x 3' 3"	1	W	4' x 3' 3"	12
D	6' 2" x 4' 0"	1	W-1	6' 2" x 3' 3"	1
D-1	6' 3" x 3' 0"	3			
D-2	6' 3" x 3' 0"	3	HLW	3' x 1' 0"	3
D-3	6' 3" x 2' 0"	9	V	1' x 1' 0"	36

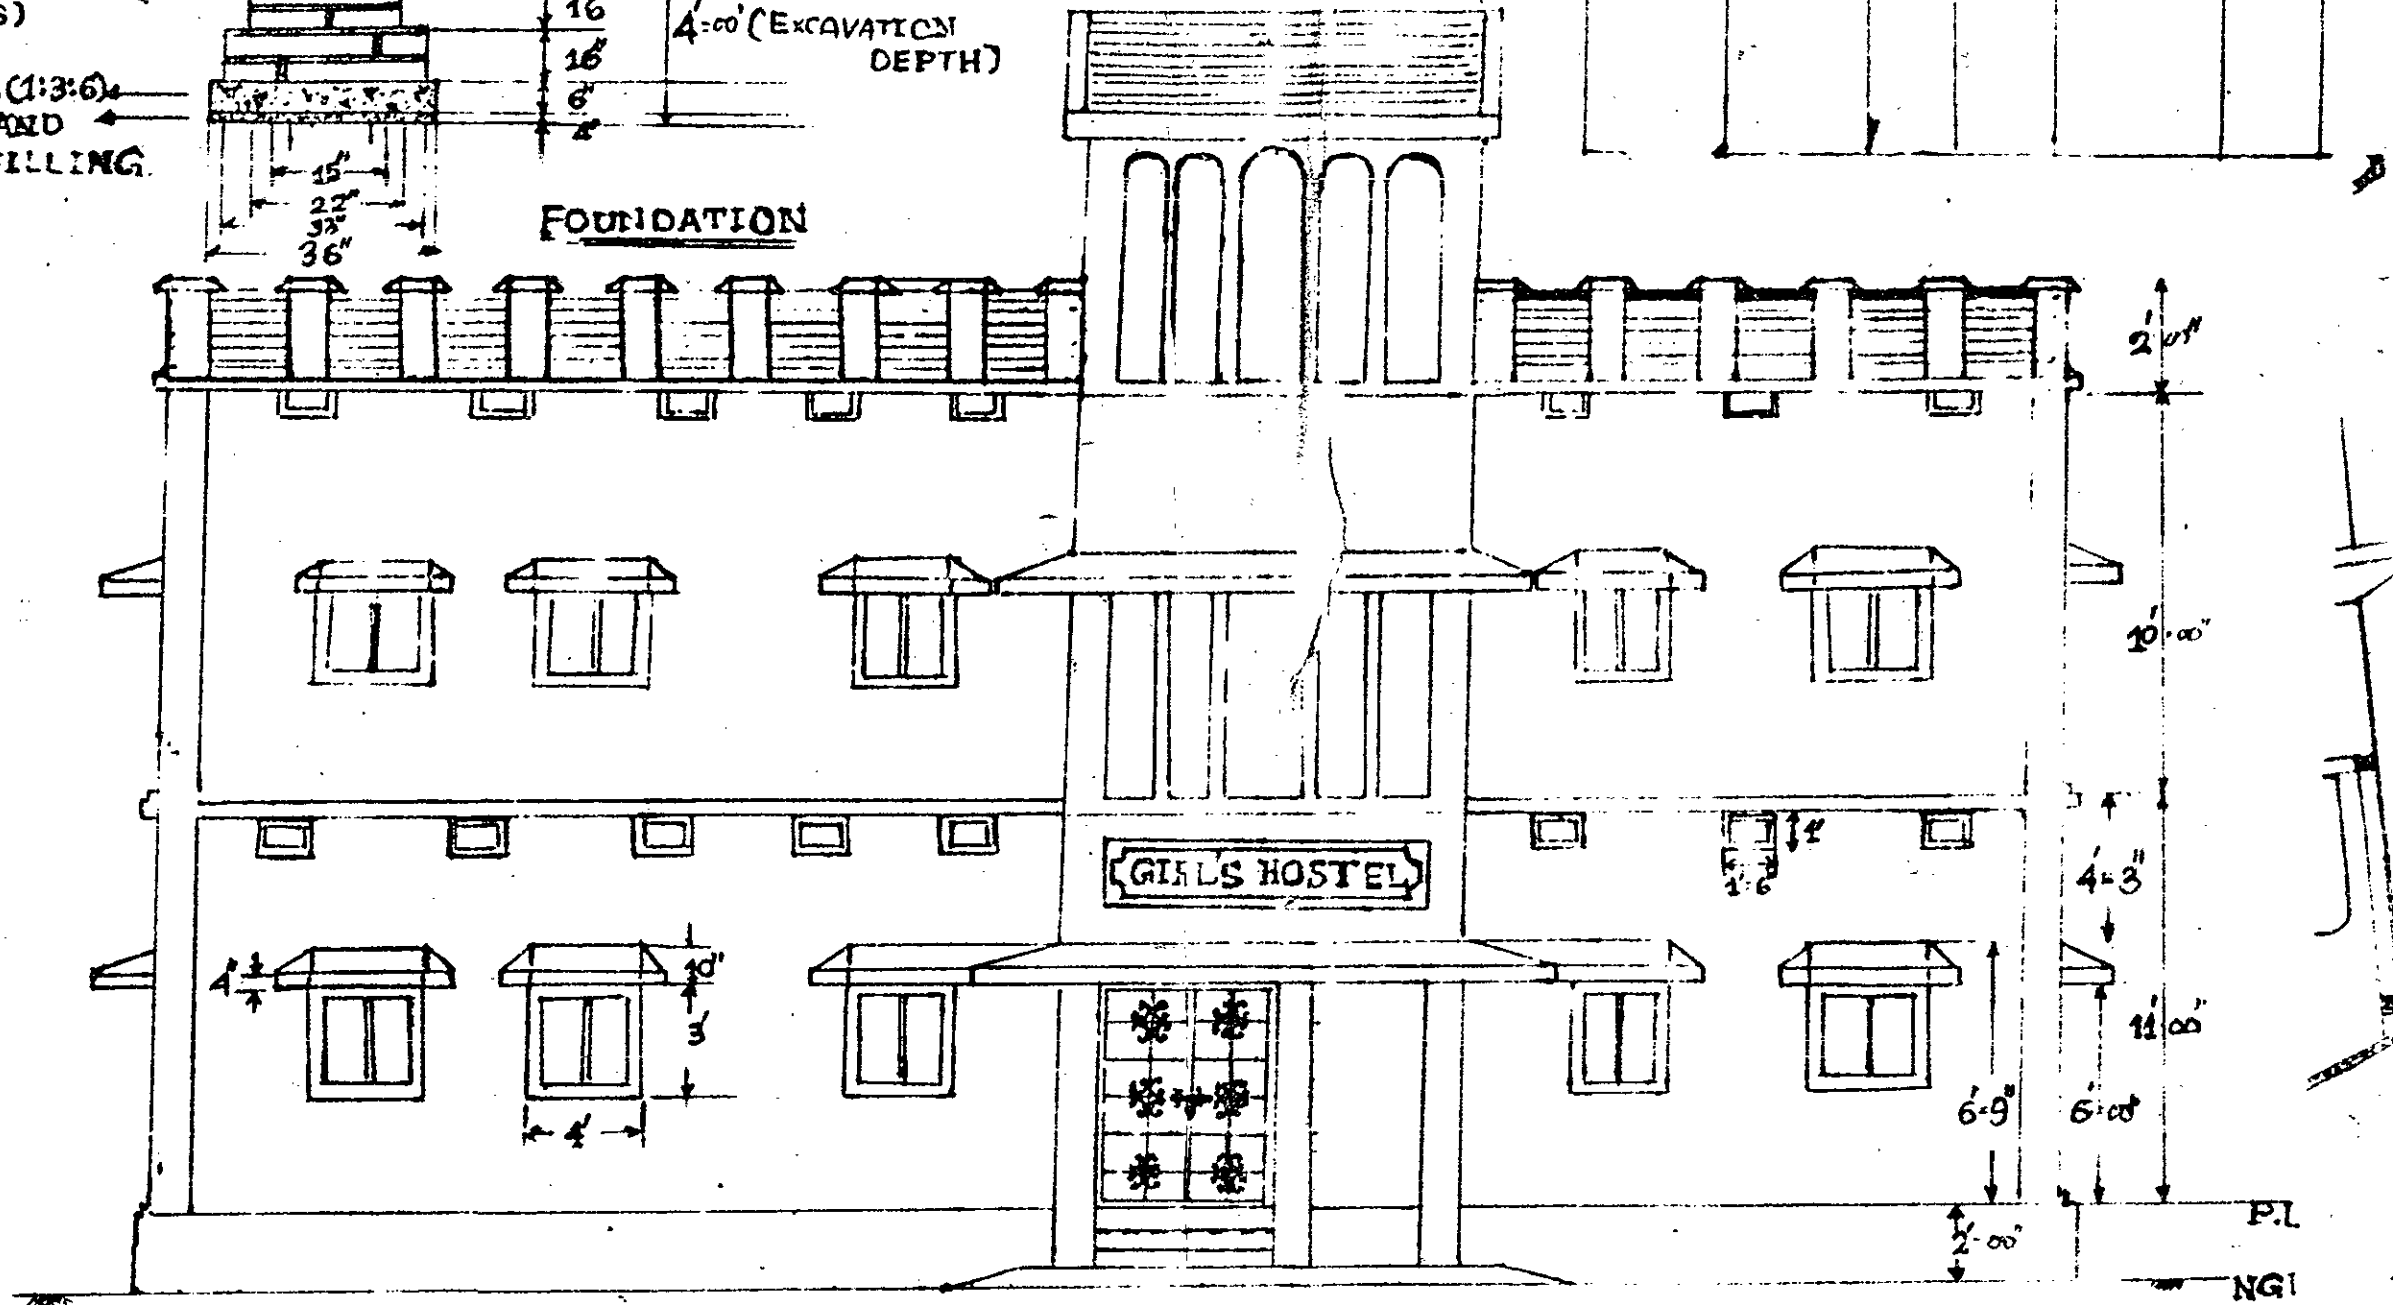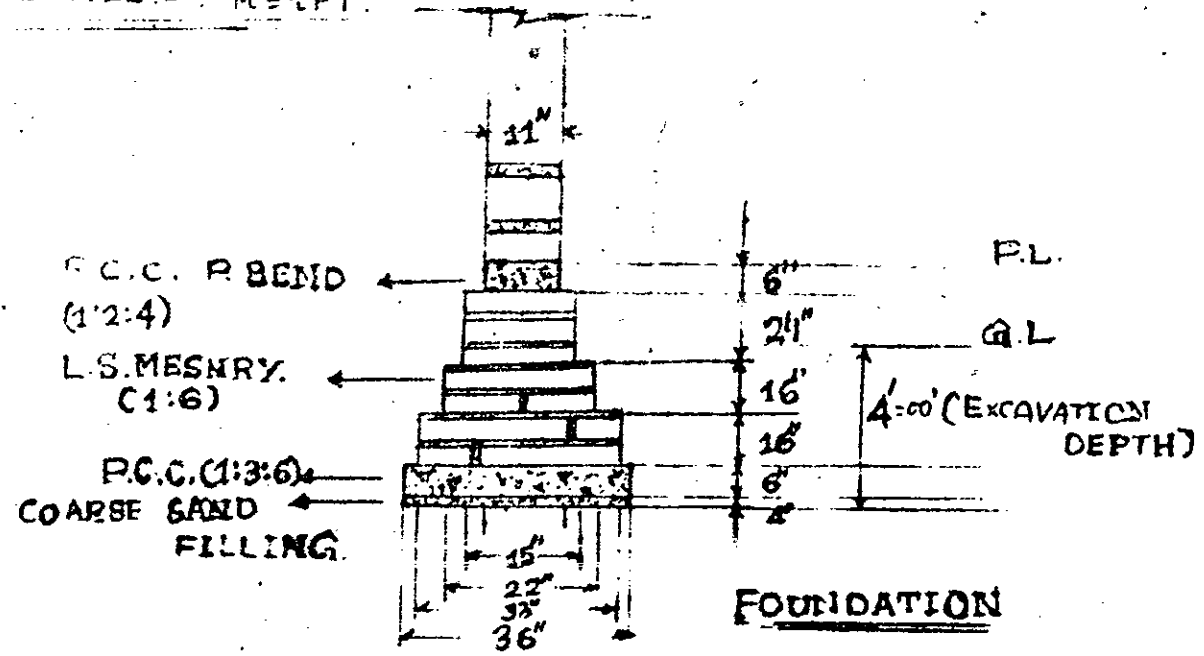


N.B.

ELEVATION


Existing Building of praramana college of physical Education & Yoga, Tuguegarao

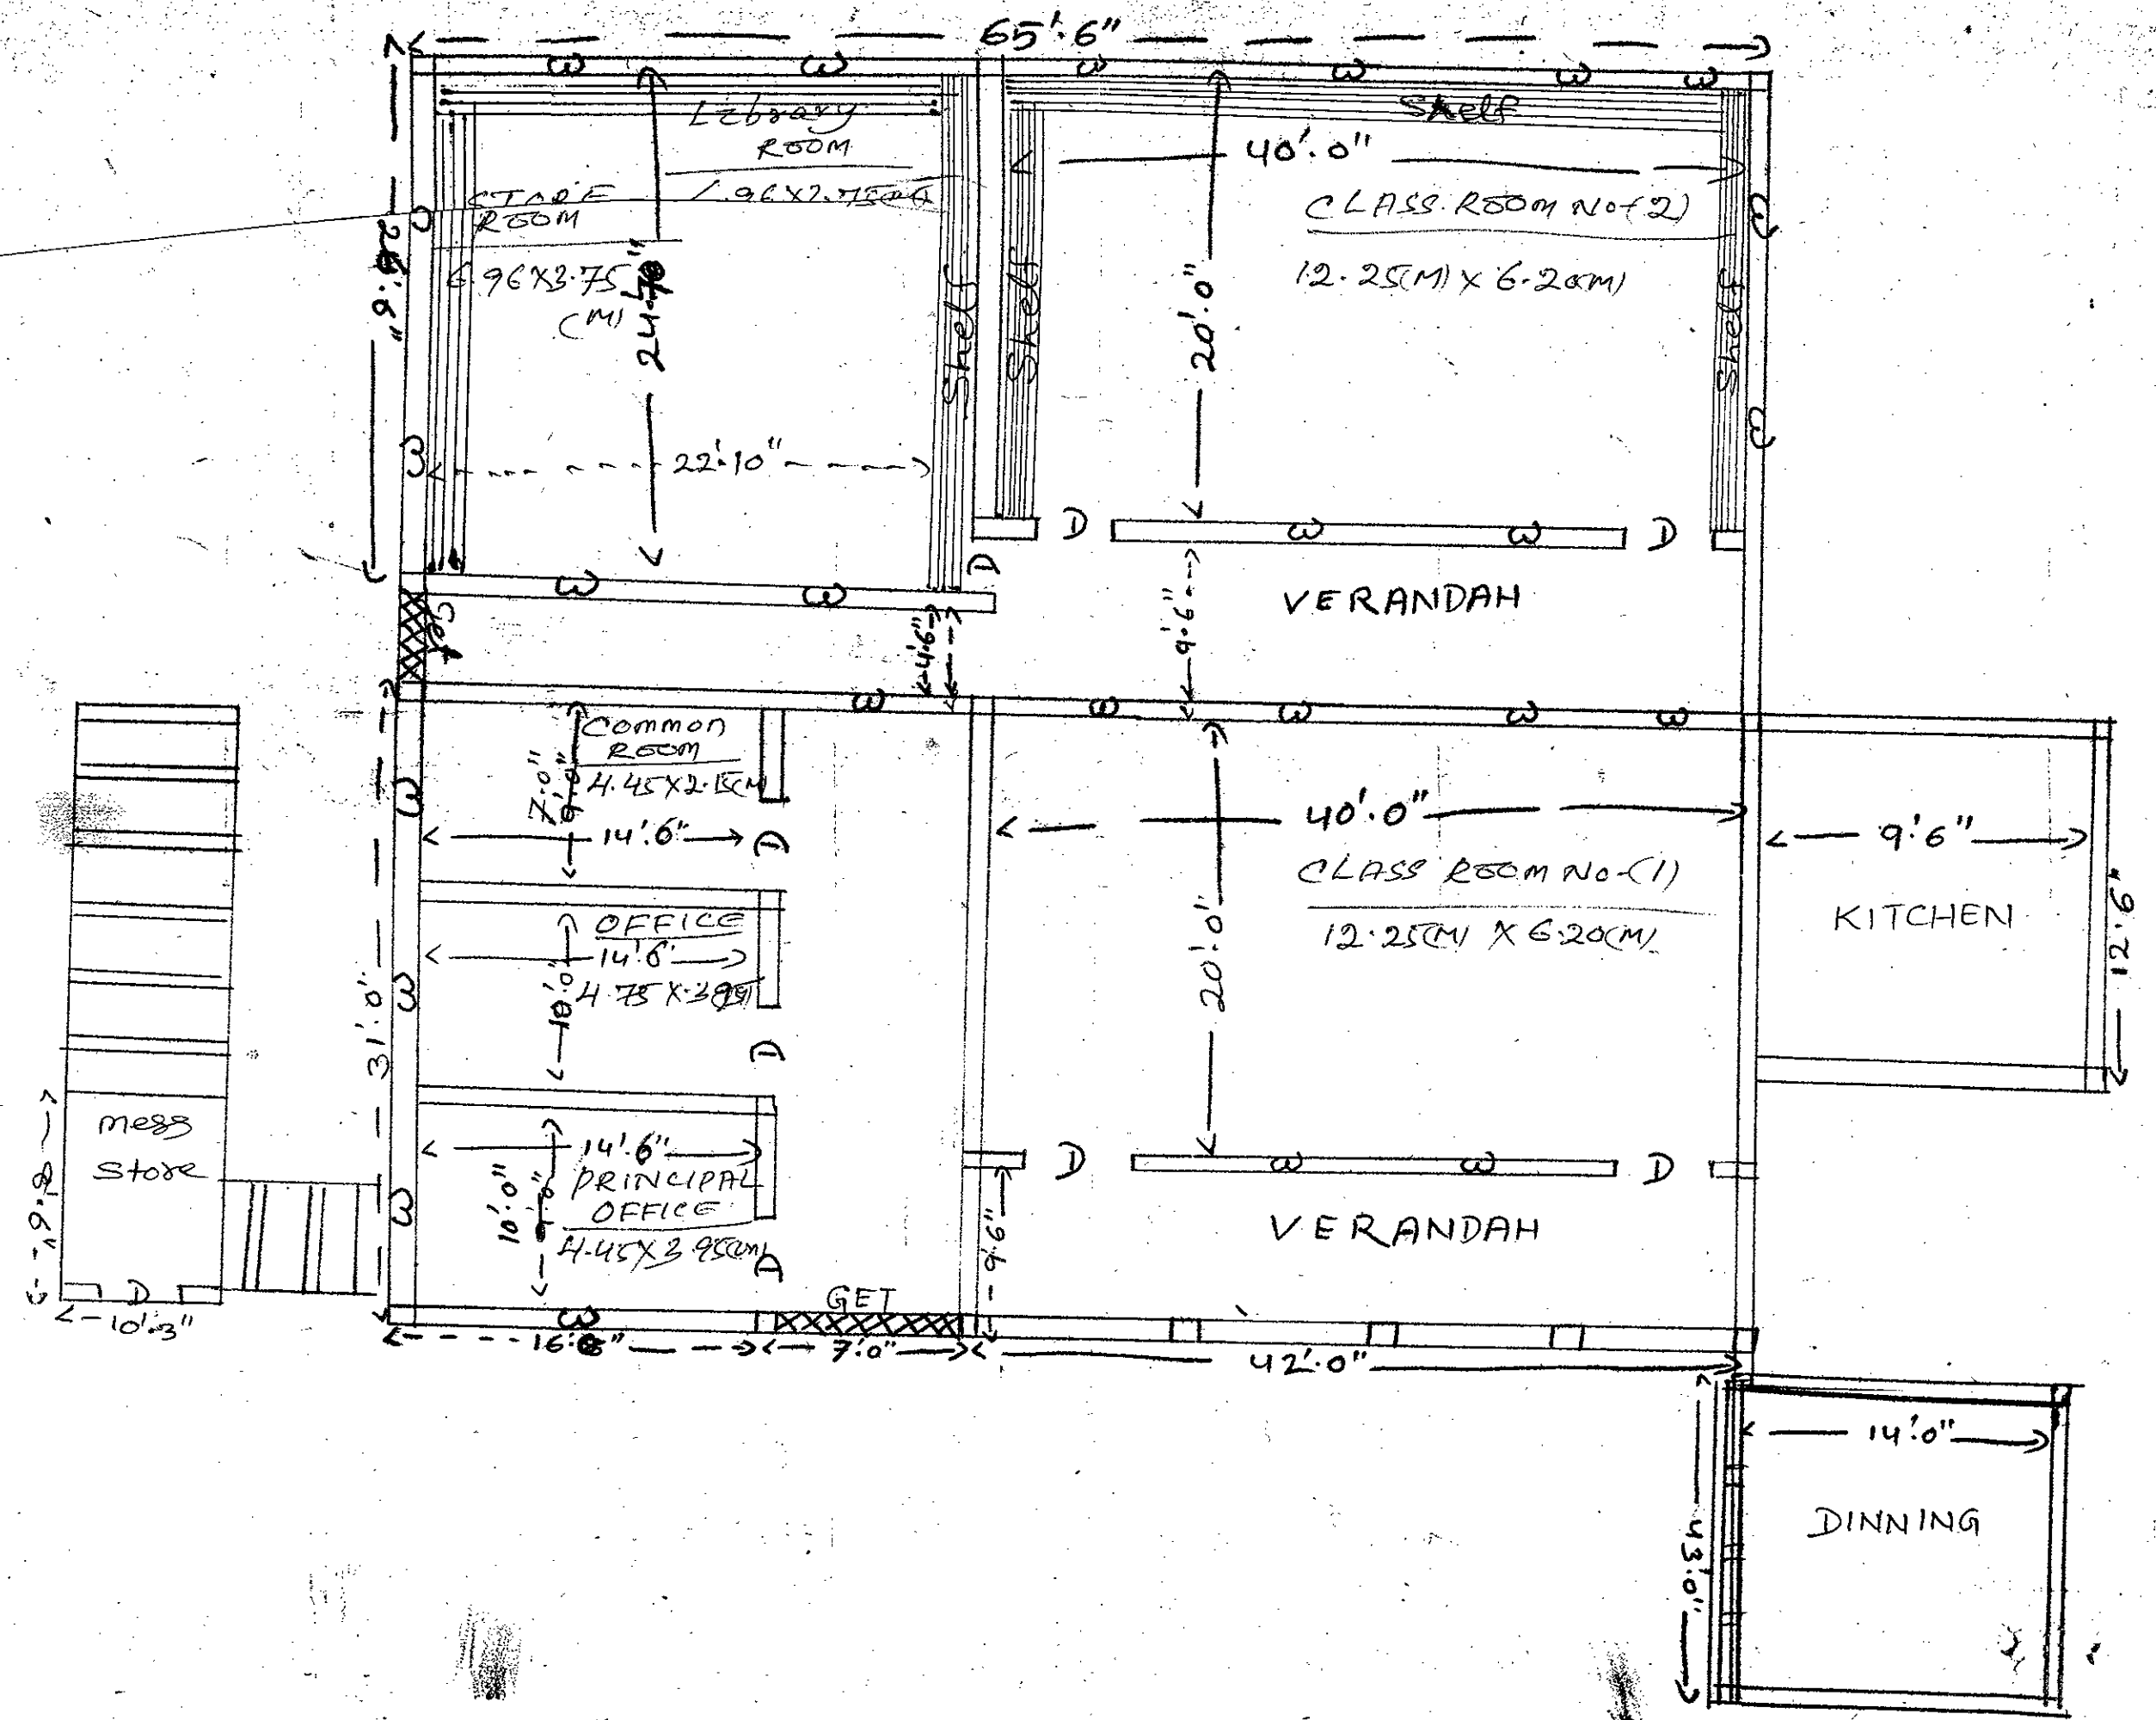

SCALE - 1 CM = 1 FT.

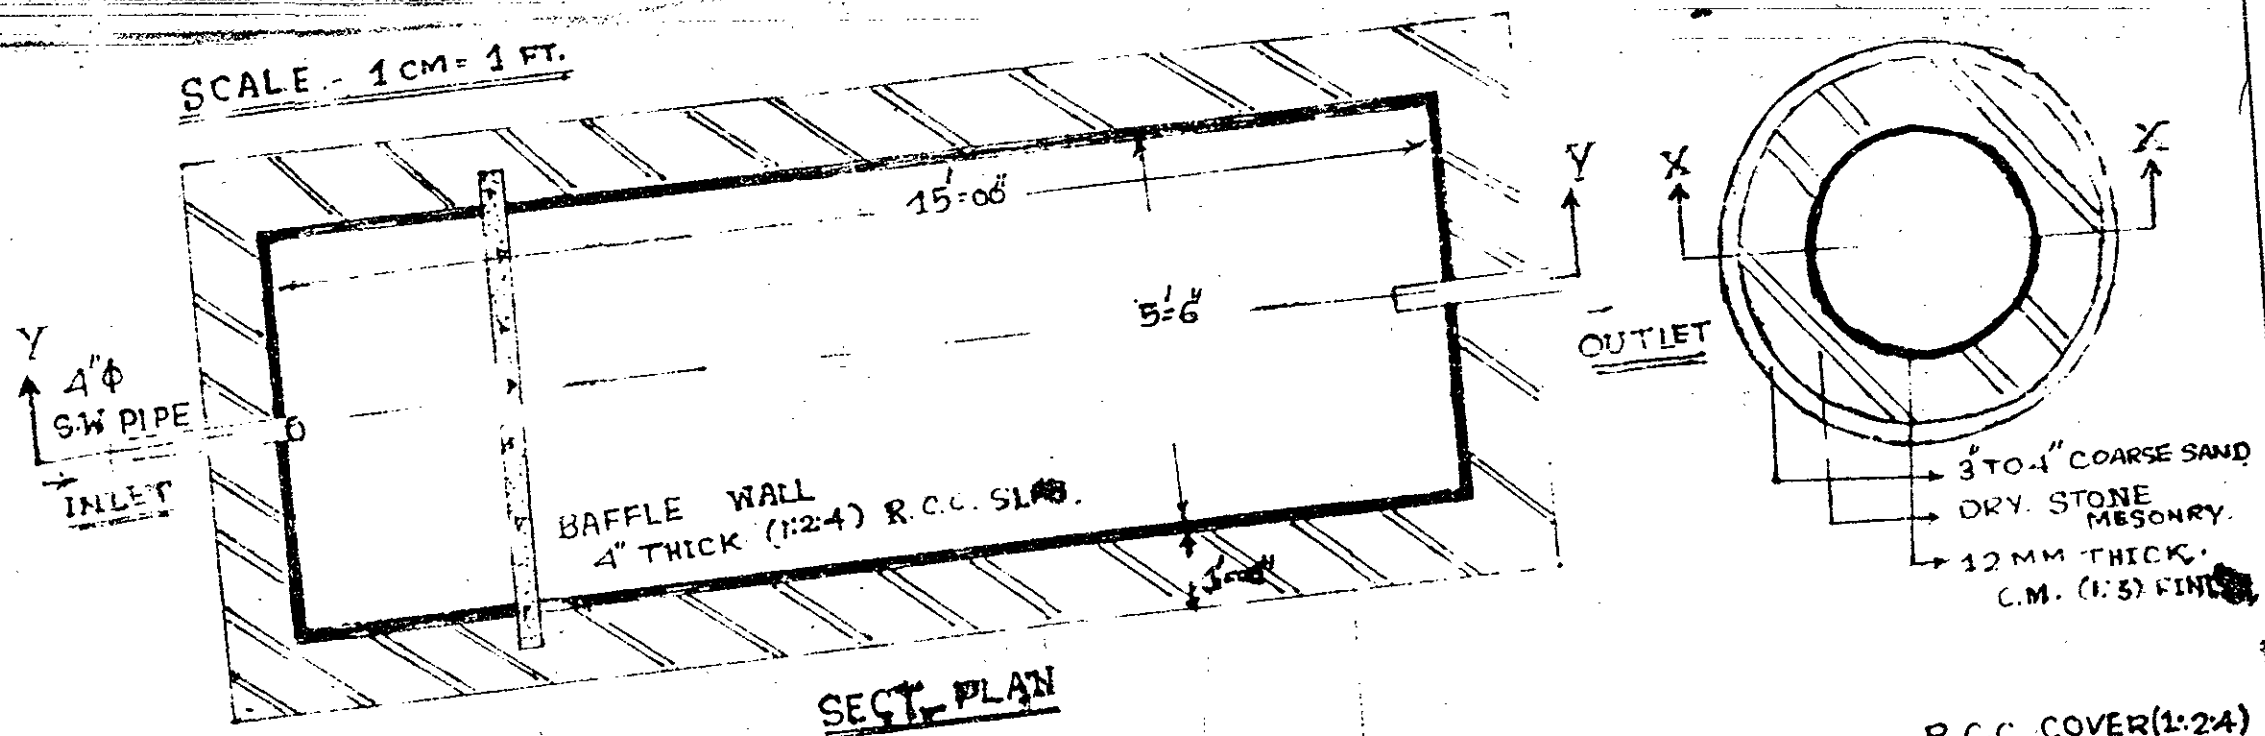

SECT. PLAN

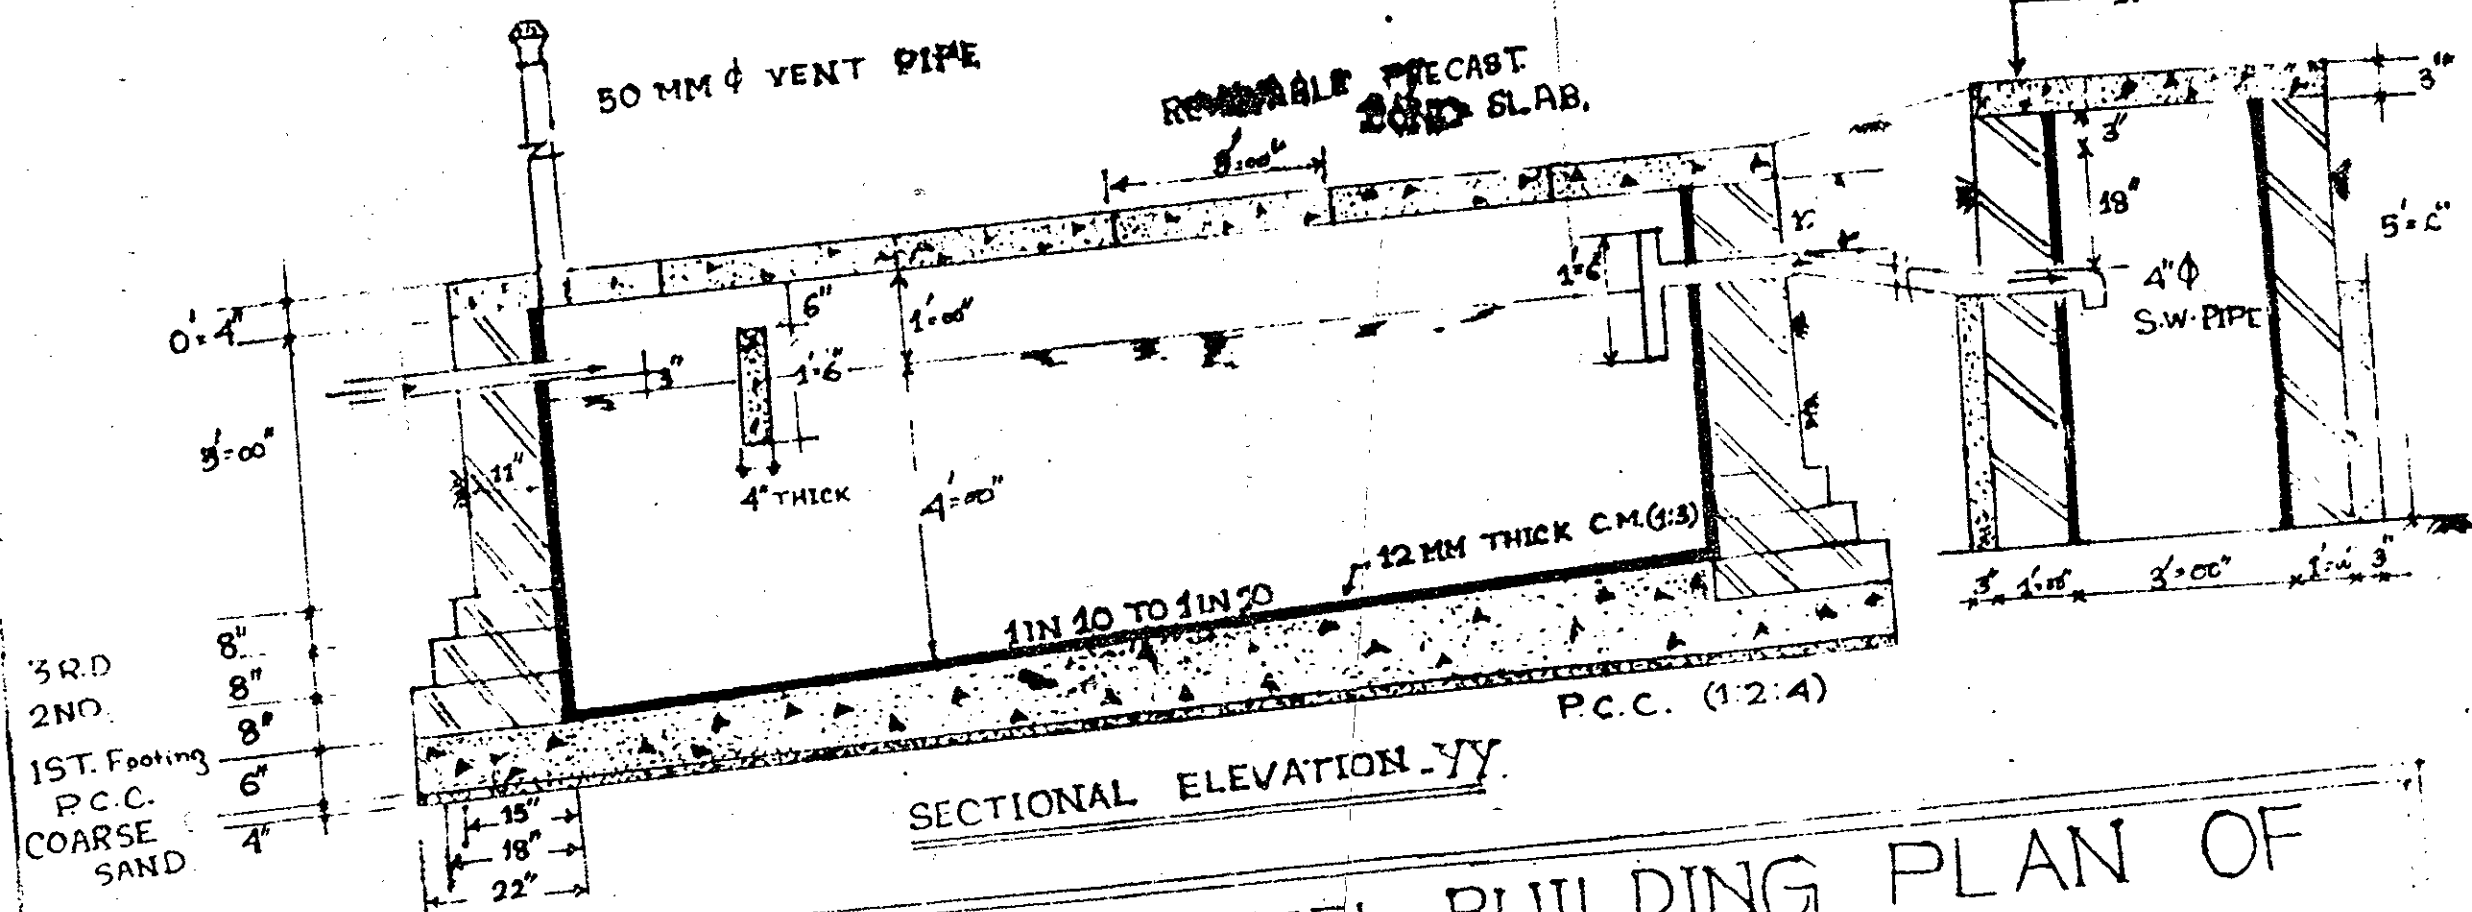


SECTIONAL ELEVATION YY

PROPOSED HOSTEL BUILDING PLAN OF
 P.M.C.P.E. COLLEGE OVER PLOT No. KHATA No.
 TIGIRIA, CUTTACK.

SIGN. OF PERSON

SIGN. OF APPLICANT

2 FT

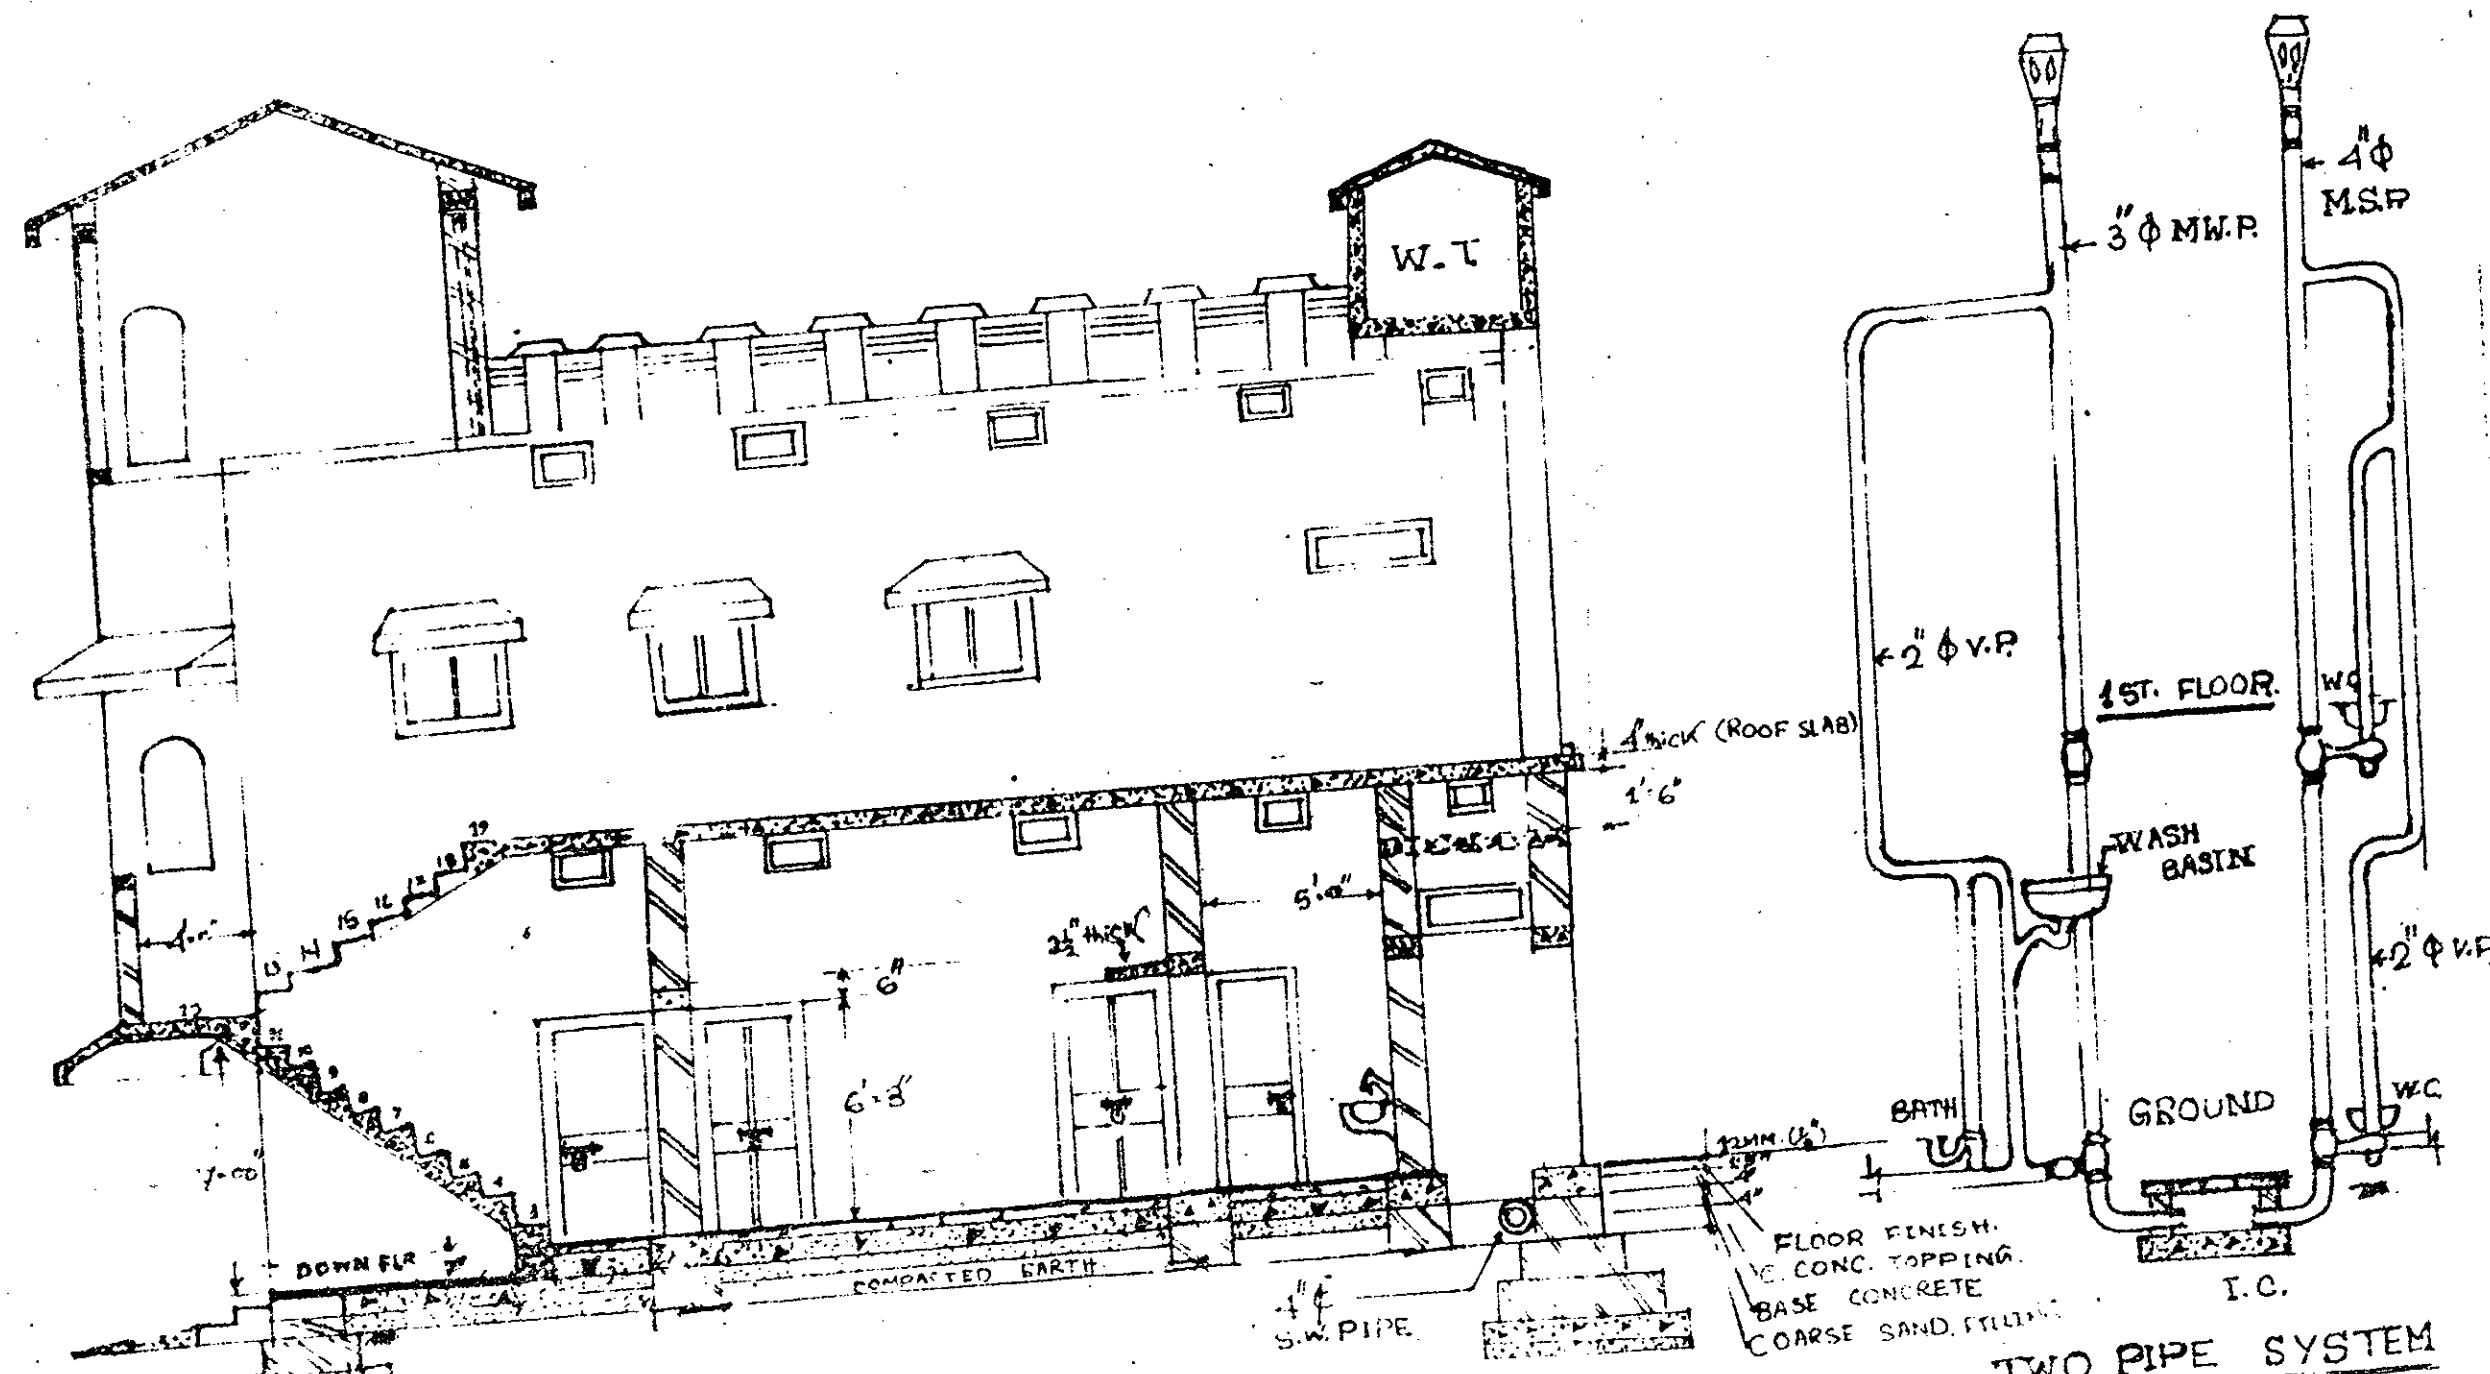


SECT. AA / SIDE VIEW

RISE - 7"
TRADE - 10"

TWO PIPE SYSTEM


2 FT

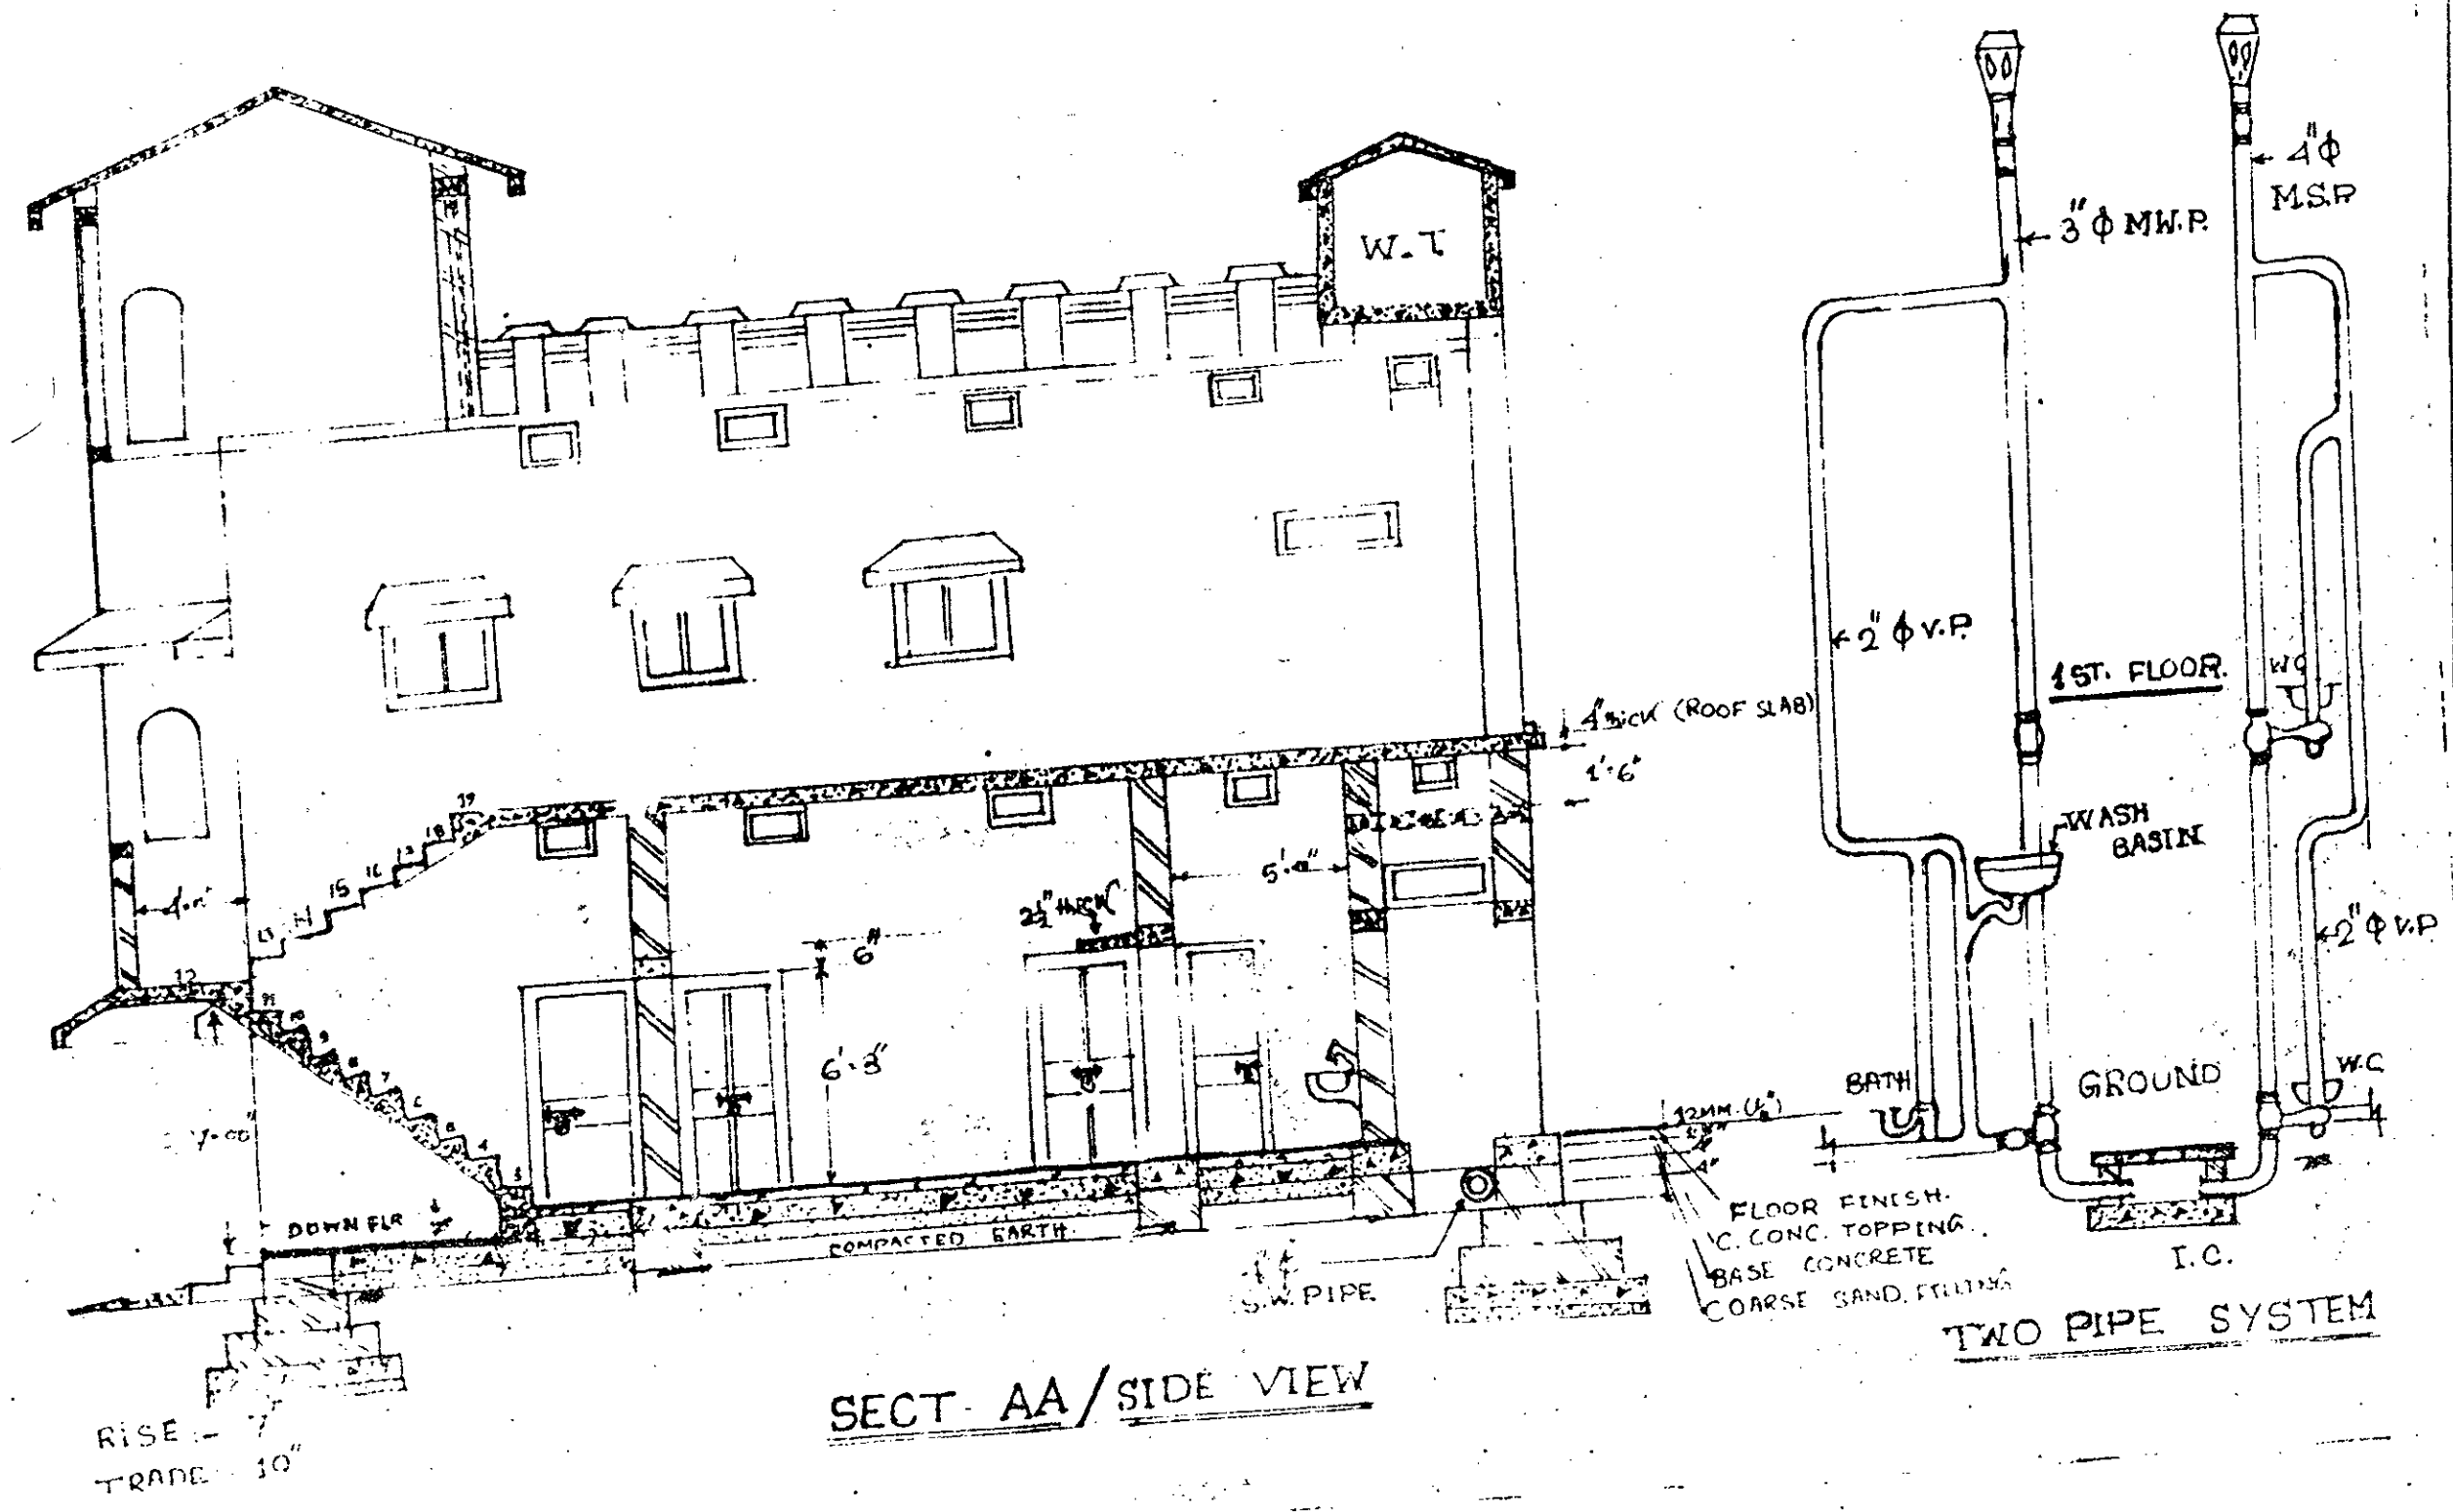


SECT. AA / SIDE VIEW

TWO PIPE SYSTEM

SCALE - 1 CM = 1 FT.

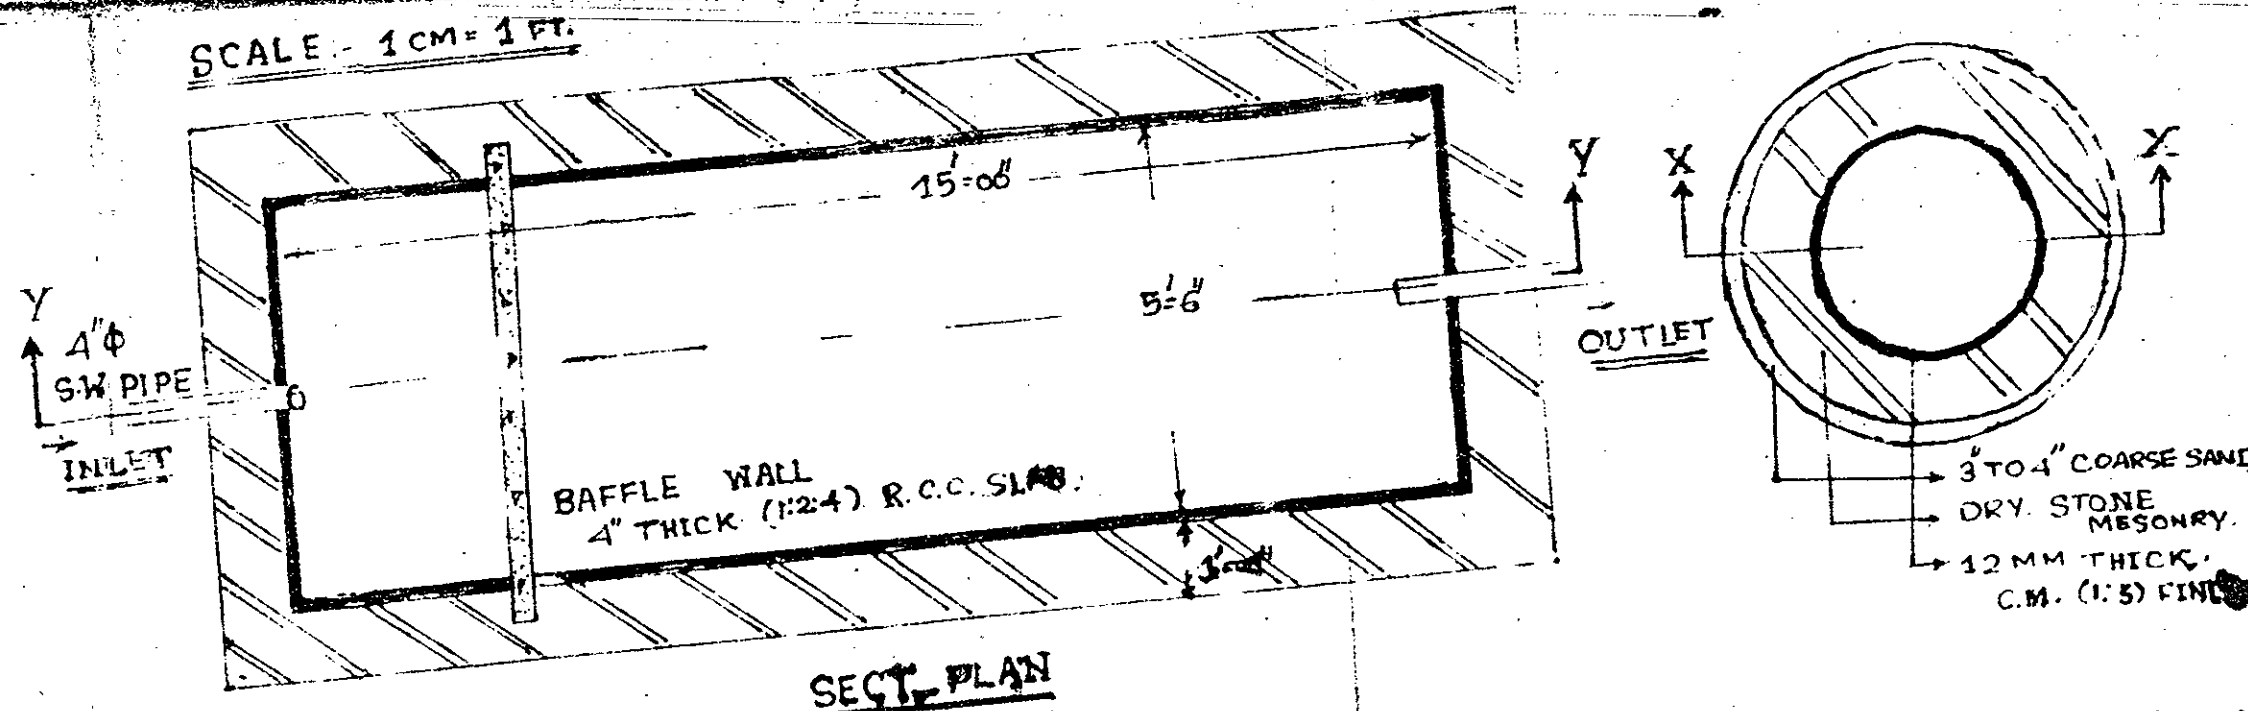

SECT. PLAN

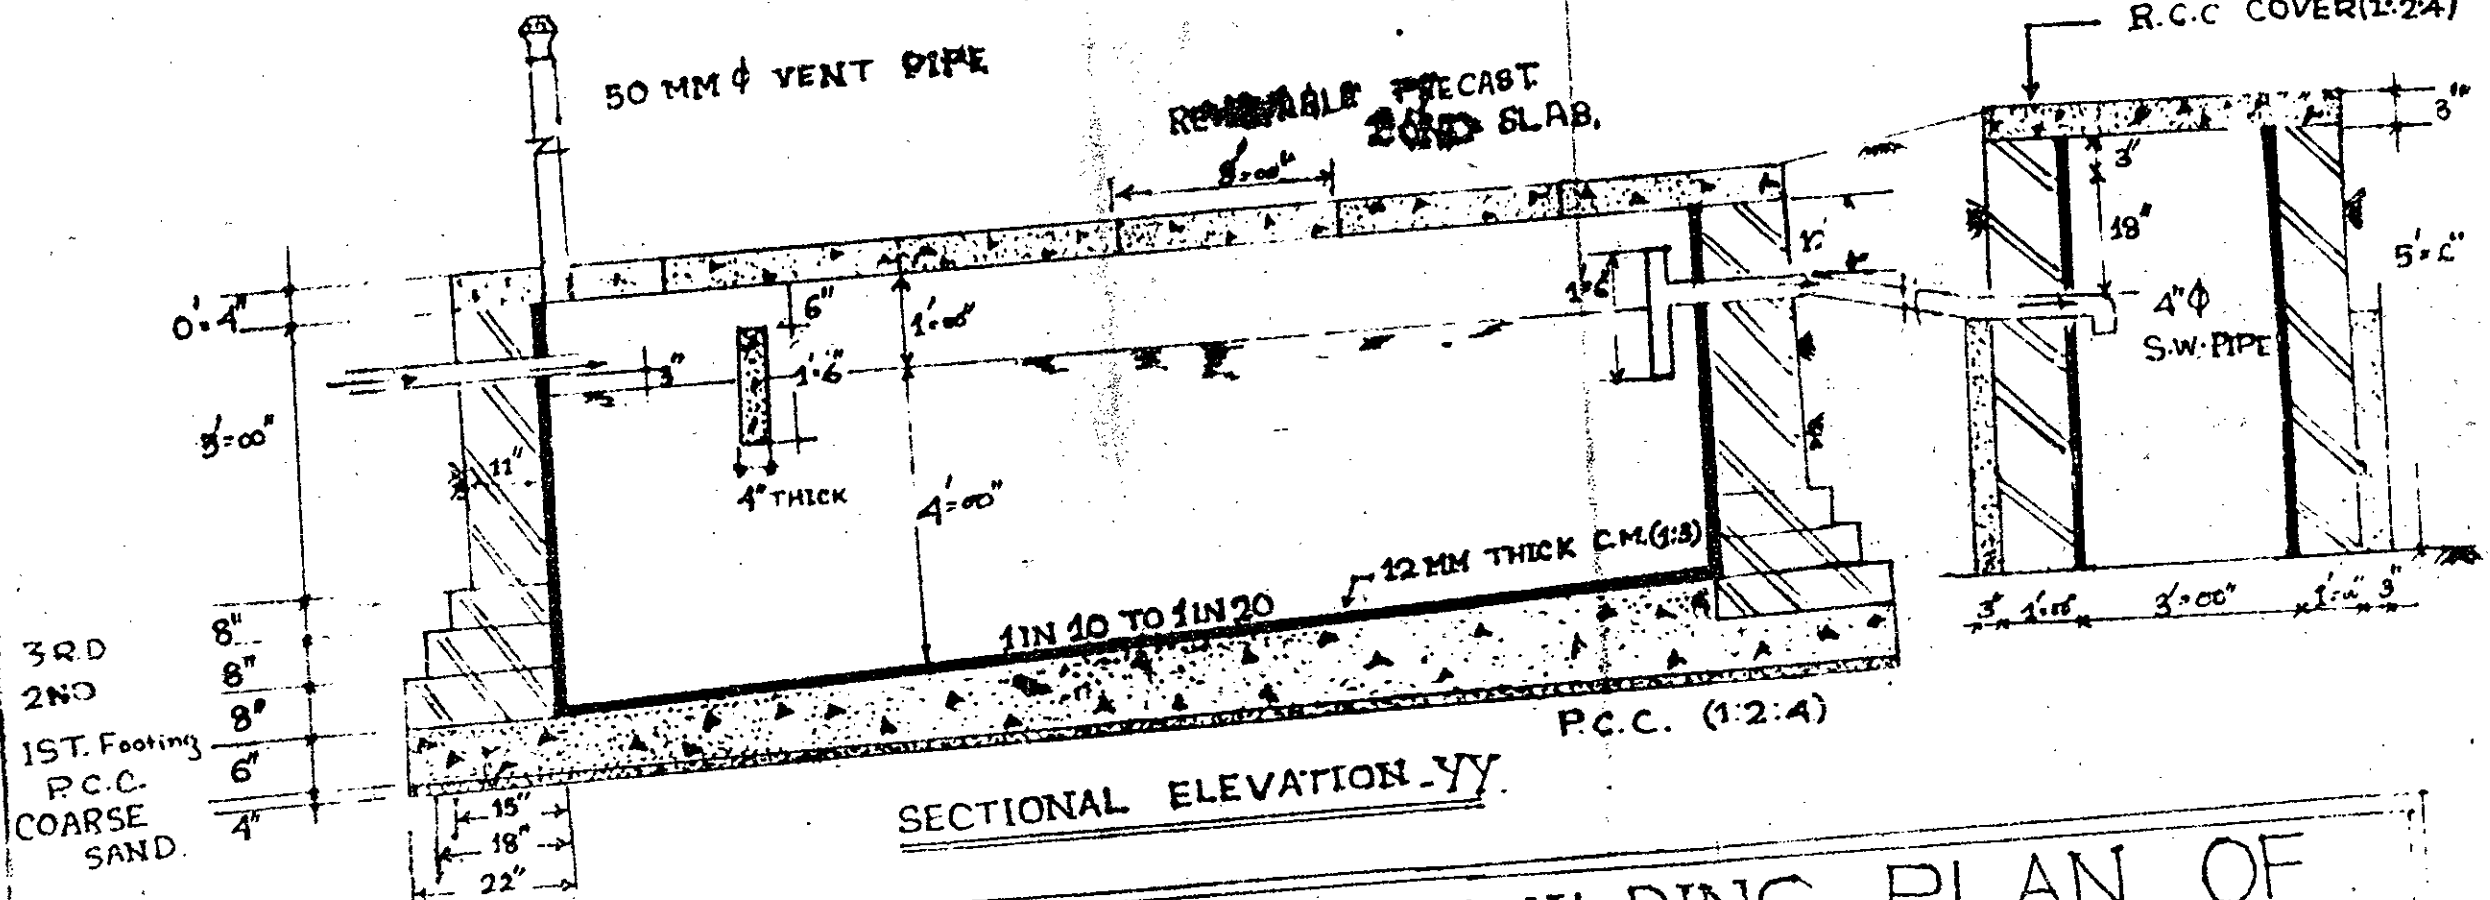


SECTIONAL ELEVATION YY

PROPOSED HOSTEL BUILDING PLAN OF
 P.M.C.P.E. COLLEGE OVER PLOT No. KHATA No.
 TIGIRIA, CUTTACK.



SIGN. OF
 TECHNICAL PERSON

SIGN. OF
 APPLICANT.

SCALE - 1 CM = 1 FT.

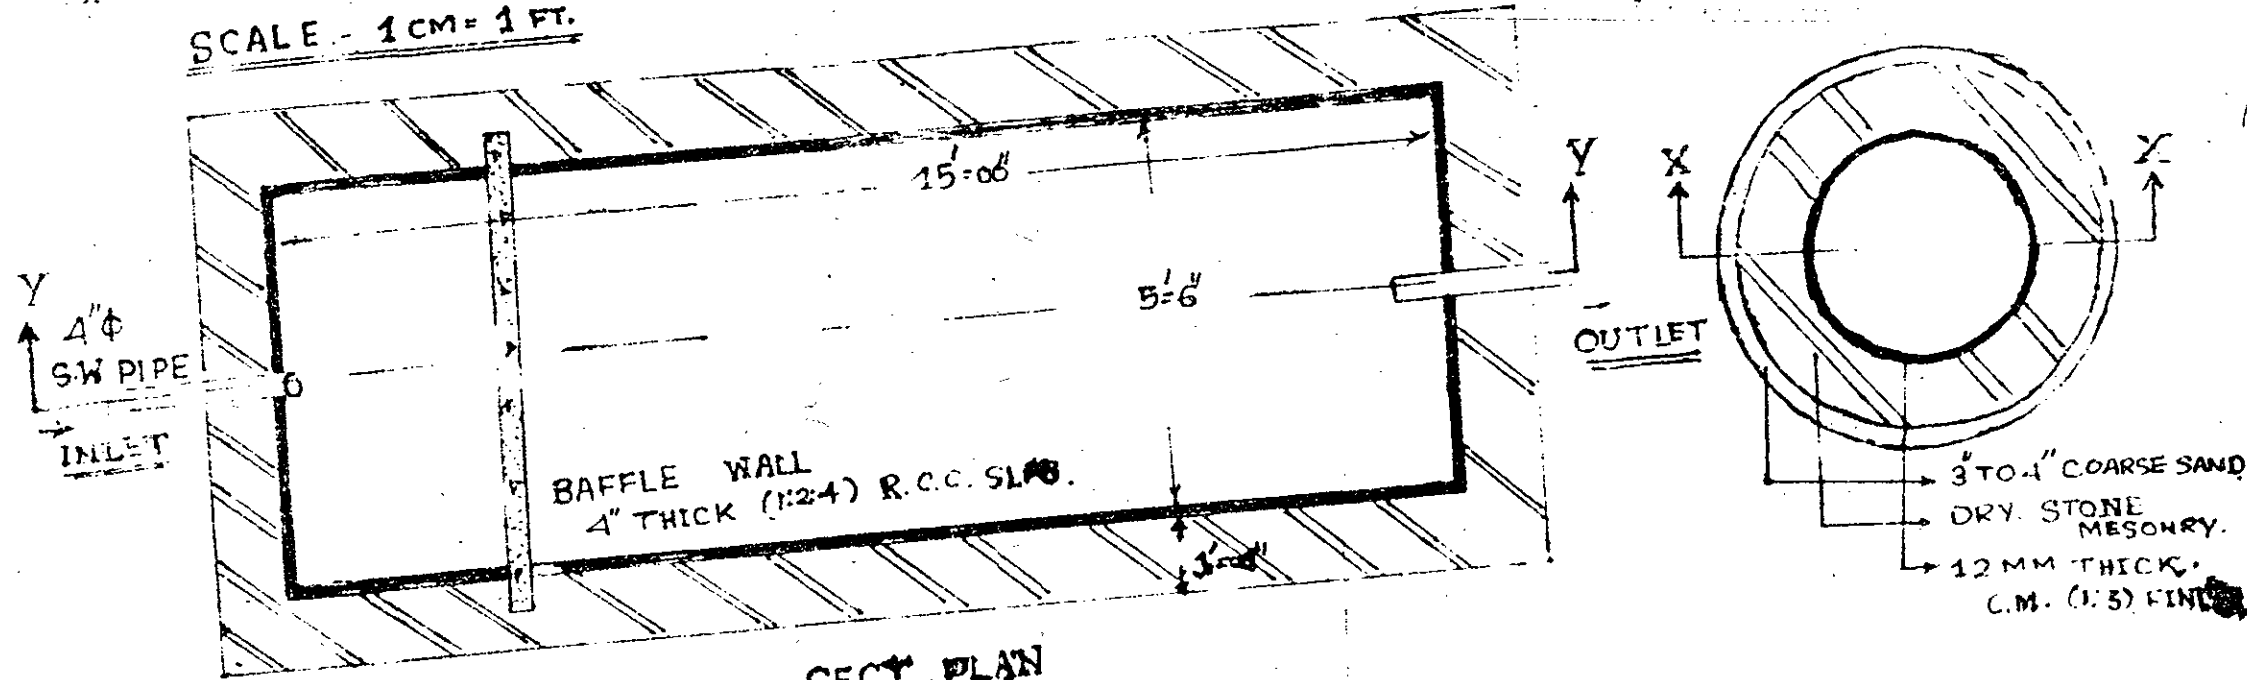

SECT. PLAN

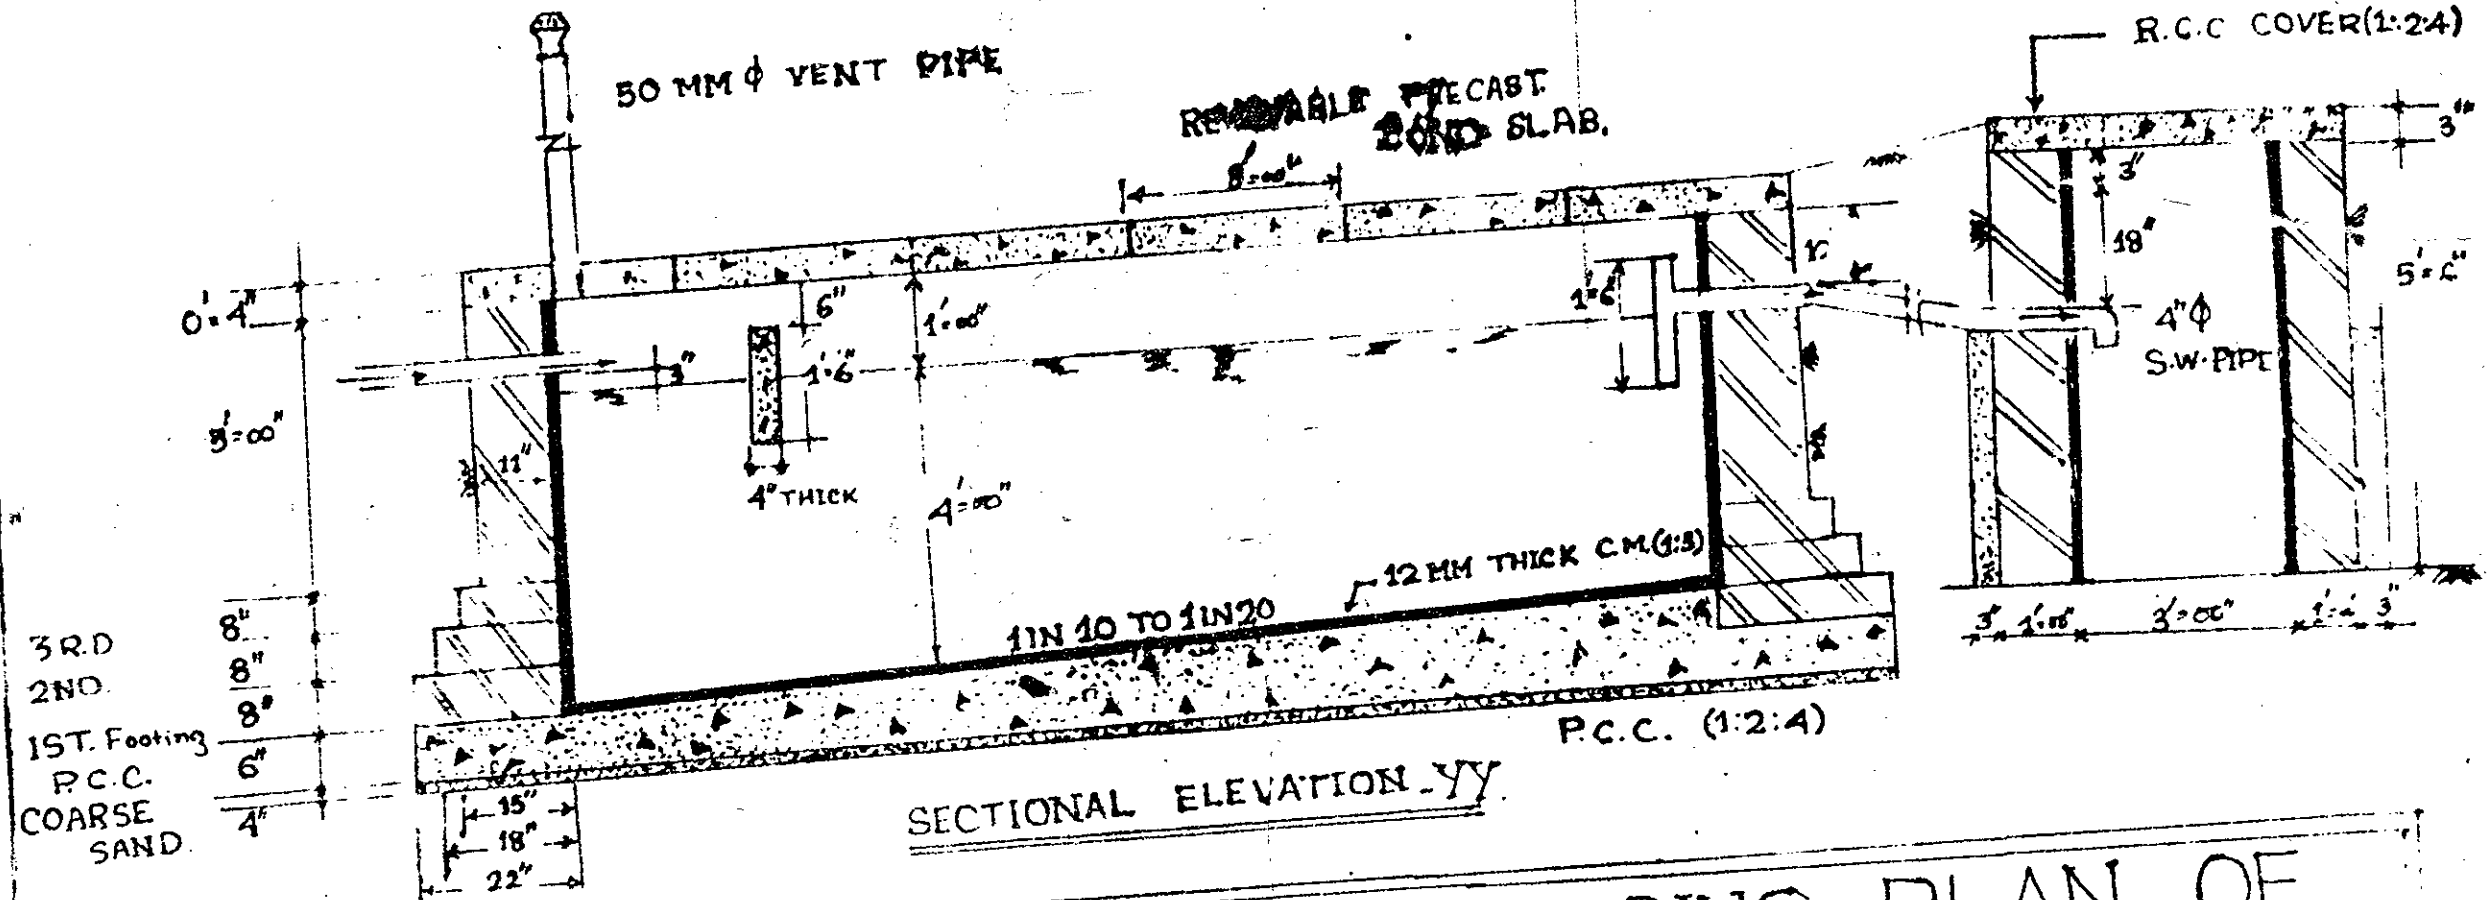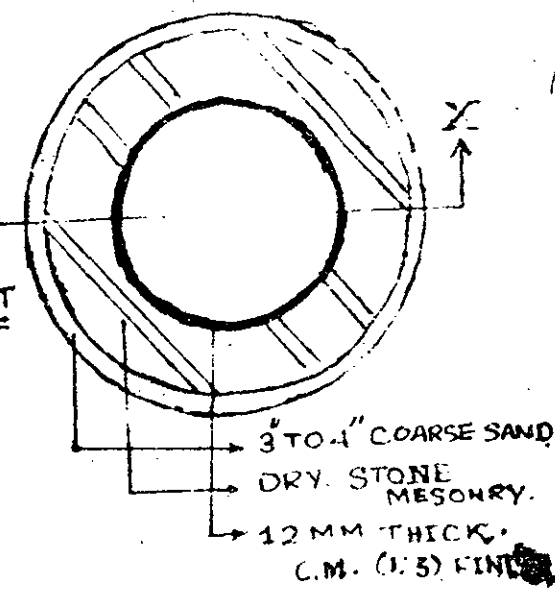


SECTIONAL ELEVATION YY

PROPOSED HOSTEL BUILDING PLAN OF
 P.M.C.P.E. COLLEGE OVER PLOT No. KHATA No.
 TIGIRIA, CUTTACK.

SIGN. OF
 PERSON

SIGN. OF
 APPLICANT

LADIES HOSTEL BUILDING AT P.M.C.P.ED & YOGA MAHA VIDYALAYA AT TIGIRIA BLOCK .

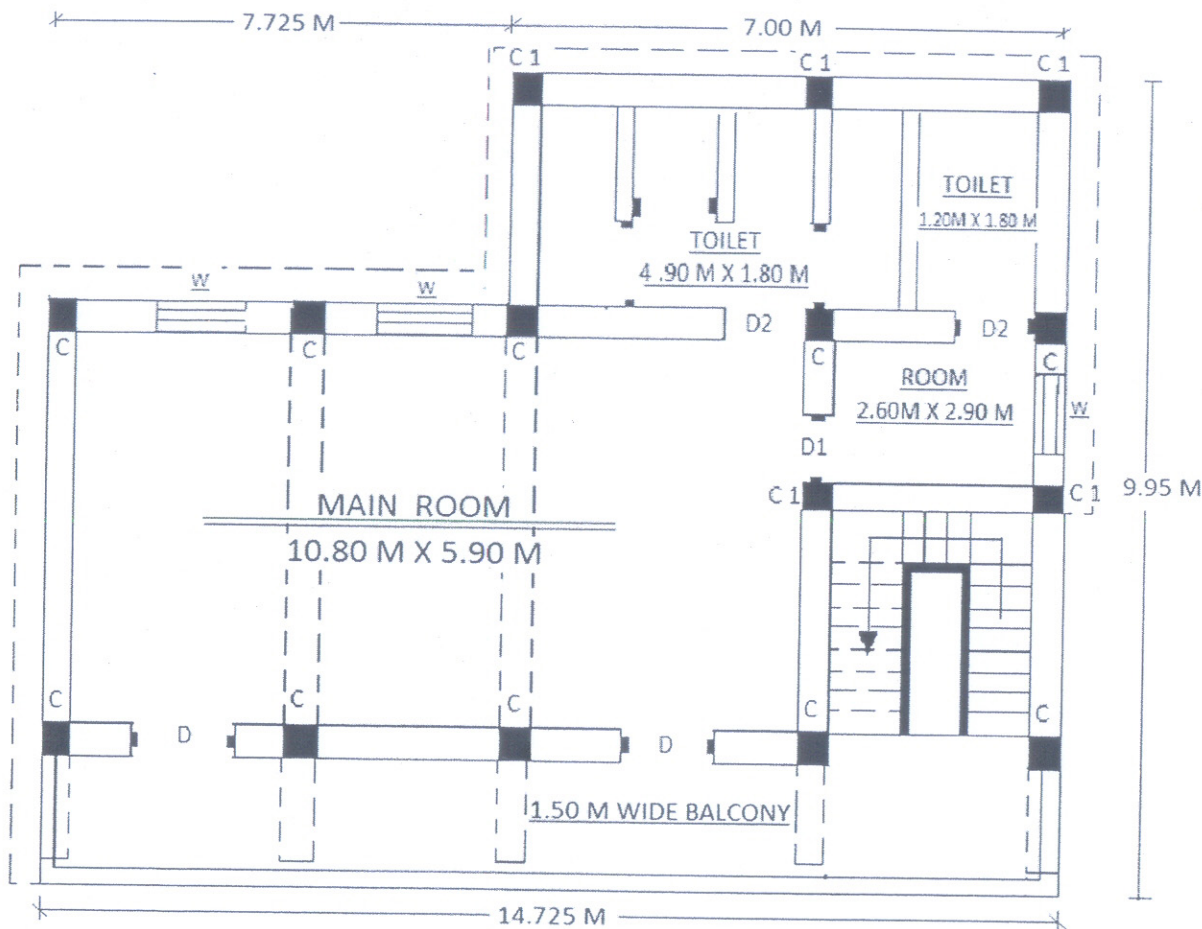

SECOND FLOOR PLAN


REFERENCE

C	0.30 M X 0.60 M
C1	0.25 M X 0.25 M
B	0.30 M X 0.45 M
D	1.50 M X 2.10 M
D1	1.00 M X 2.10 M
D2	0.90 M X 2.10 M
W	1.20 M X 1.40 M
WALL THICKNESS 0.25 M	
PARTITION WALL 0.125 M	

ALL DIMENSIONS ARE IN MTR AND NOT TO SCALE .

M. S. K. M.
12/1/18
Junior Engineer
Tigiria Block

LADIES HOSTEL BUILDING AT P.M.C.P.ED & YOGA MAHA VIDYALAYA AT TIGIRIA BLOCK.

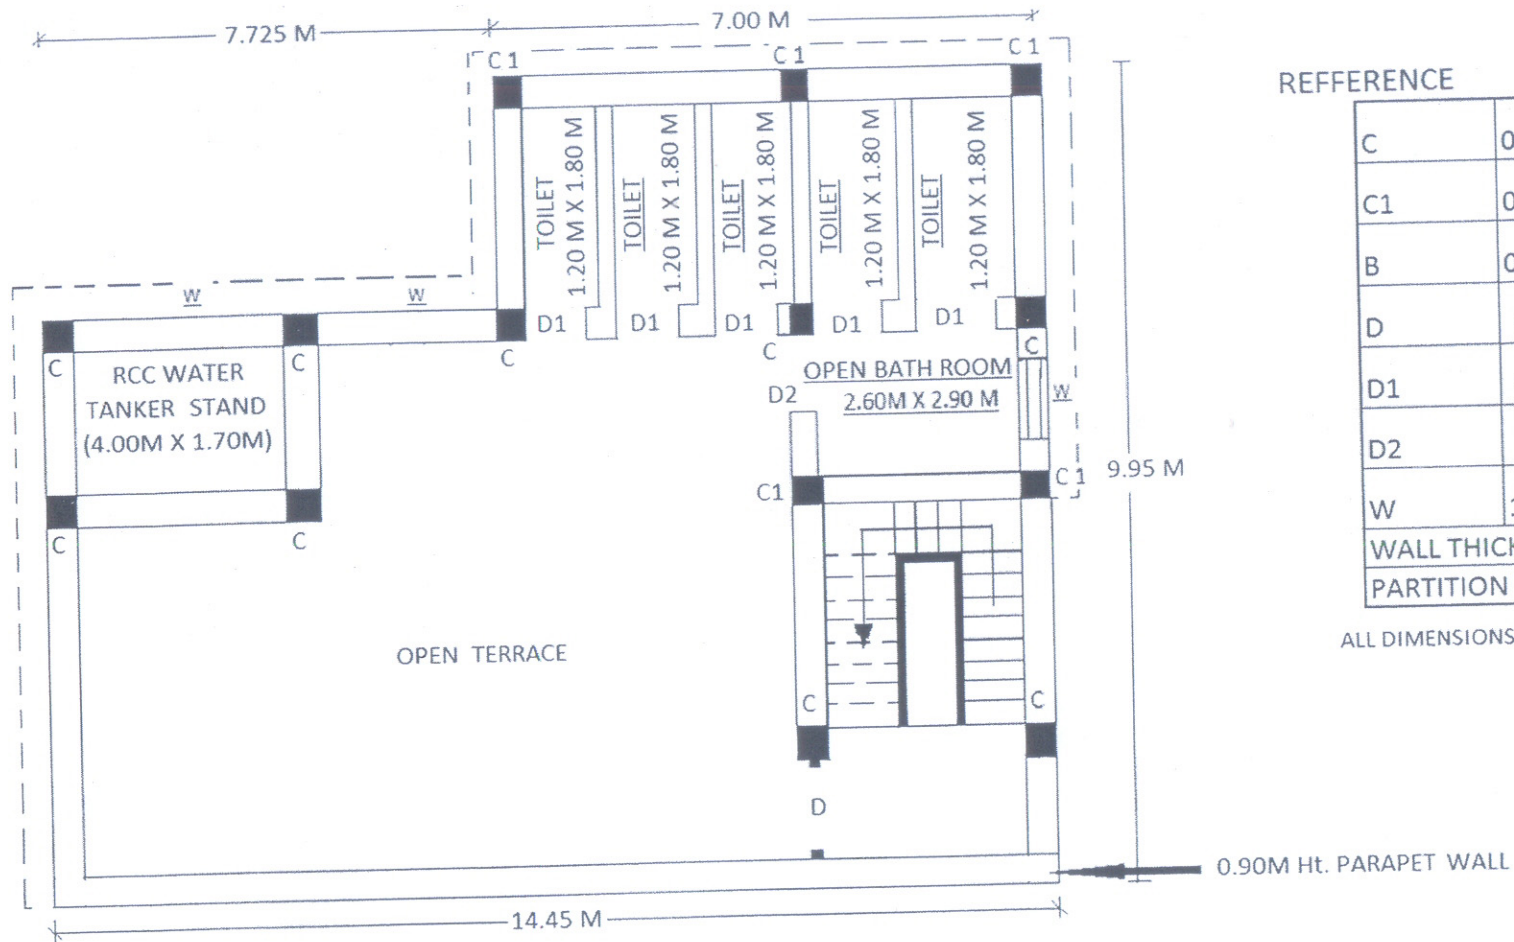

REFERENCE

C	0.30 M X 0.60 M
C1	0.25 M X 0.25 M
B	0.30 M X 0.45 M
D	1.05 M X 2.10 M
D1	0.75 M X 2.10 M
D2	1.00 M X 2.10 M
W	1.20 M X 1.40 M
WALL THICKNESS 0.25 M	
PARTITION WALL 0.125 M	

ALL DIMENSIONS ARE IN MTR AND NOT TO SCALE.

THIRD FLOOR PLAN

Mowwan
A/C/18
Junior Engineer
Tigiria Block